

MISSISSIPPI DEPARTMENT OF NATURAL RESOURCES

Bureau of Land and Water Resources

Southport Mall

P.O. Box 10631

Jackson, Mississippi 39209

WATER WELL DRILLERS LOG CODED

WASHINGTON
 B
 9-1-83

Sept 01, 1983 date well completed
 Larry's Well & Pump firm name
 Washington county well located

LANDOWNER: <u>W.C. Spates</u>	description of formations encountered	from	to
<u>Avon, Ms.</u> (mailing address)			
WELL LOCATION:			
sec. <u>6</u> T. <u>16</u> N R. <u>8</u> E S W			
<u>5</u> miles <u>west</u> of <u>Arcole</u> (distance) (direction) (nearest town)			
WELL PURPOSE: (home, irrigation, municipal, industrial)			
WELL COMPLETION DATA:			
(1) diameter (inches) <u>16"</u>			
(2) total depth (feet) <u>90'</u>			
(3) static water level (feet) <u>22</u> below/above top of ground.			
(4) casing <u>Steel</u> , <u>50'</u> (material) (depth)			
(size) if telescope see back.			
(5) screen <u>40'</u> , <u>50'</u> (length) (depth to top)			
<u>16"</u> , <u>steel</u> (size) (material)			
(6) pump <u>30</u> , <u>1200</u> (HP) (yield gpm)			
(type power)			
(7) electric log <u>No</u> (yes or no)			
(organization running log)			
(8) how well bottom plugged <u>Steel Plate</u>			
DRILLERS REMARKS:			

CODED


DEPT. OF NATURAL RESOURCES
 BUREAU OF LAND & WATER RESOURCES

FEB 15 1984

RECEIVED

If well telescopes please sketch and show depths.

GROUND LEVEL

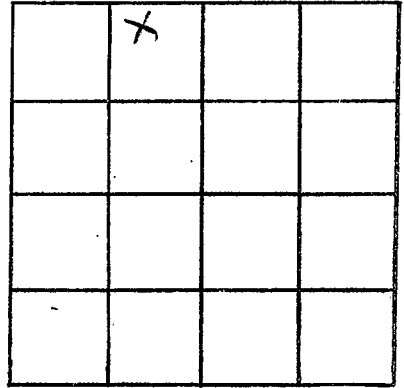

SECTION 6

Please indicate well location X.

ADDITIONAL INFORMATION

If more than one screen,
show locations of each on sketch.