

WASH.  
K 14  
8-31-64

WATER WELL DRILLERS LOG

Date: 8/31, 1964, Driller: Bailey Drlg. Co County: Washington  
(Name)

(1) Owner of Land: Avon Gin Co  
(Name)  
Avon, Miss.  
(Address)

(2) Location: 1/4, 1/4, Sec. 14 T. R  
of Avon miles of (Nearest Town)  
(distance) (direction) (Level)

(3) Topography: Flat  
(Hilly) (Flat) (Level)

(4) Purpose of Well: Industrial  
(Domestic Irrigation  
Municipal, Industrial, Other)

Description & Color of Materials Sand, Clay, Red Clay Shell, etc.	Thick- ness Feet	Depth Feet
Clay		20
Sand	50	70
Gravel	30	100
Mud		300
Sand	80	380
Mud		440
Sand & Mud		460
Sand	90	550
Sand & Mud		560
Rocks		570
Mud		580
Sand & Mud		630
Rocks		635
Sand & Mud		760
Sand	40	800
Mud		930
Rocks		932
Mud		980
Sand		1150

Information upon completion of well:

(1) Diameter 4x3 inches.

(2) Total Depth 1150 feet.

(3) Water Level 18 feet below top of ground.

(4) Cased to all way Size 4x3


(5) Screen: Size 3 Length 30 ft.

(6) Were any formations sealed against pollution?  
 \_\_\_\_\_ yes, X no.

If YES depth of formation \_\_\_\_\_

Why \_\_\_\_\_

Drillers Remarks: \_\_\_\_\_

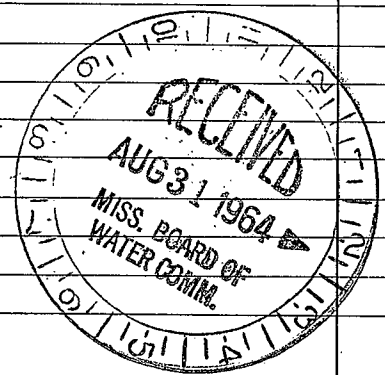

(Use Back Side)

Well No.

Faint, illegible text, possibly bleed-through from the reverse side of the page. The text is arranged in several paragraphs and appears to be a formal document or letter.