

Washington

K 15

MISSISSIPPI BOARD OF WATER COMMISSIONERS

9/19/66
2208

7-66

WATER WELL DRILLERS LOG

Date: July 28, 19 66, Driller: Layne-Central Company County Washington
(When well drilled) (Name) (Where well is located)

(1) Owner of Land: Riverside Development
(Name) Assn., Inc.
Avon, Mississippi
(Address)

(2) Location: 1/4, 1/4, Sec. 4 T. 8N R. 8W
_____ miles _____ of Avon
(distance) (direction) (Nearest Town)

(3) Topography: flat
(Hilly) (Flat) (Level)

(4) Purpose of Well: Community Well
(Domestic Irrigation
Municipal, Industrial, Other)

Description & Color of Materials Sand, Clay, Red Clay, Shell, etc.	Thick- ness Feet	Depth Feet
Clay	15	15
Fine sand	65	80
Coarse sand	15	95
Coarse sand & pea gravel	8	103
Clay	61	164
Rock	1	165
Hard shale	16	181
Hard clay	44	225
Rock	1	226
Hard clay	38	264
Sand & clay streaks	11	275
Sand	170	445
Sand with clay streaks	68	513
Clay with fine sand strks.	61	574
Hard shale	30	604
Fine sand & shale	76	680
Shale & sandy strks.	15	695
Fine sand & shale	40	735
Shale with sandy strks.	17	752
Hard shale	8	760
White clay	41	801
Clay with sandy strks.	13	814
Rock	1	815
Clay	73	888
Rock	1	889
Hard clay	18	907
Clay with sandy strks.	70	977
Hard rock	2	979
Clay	82	1061
Clay with sandy strks.	31	1092
Sandy clay	18	1110
Sand	5	1167
Clay		1171

Information upon completion of well:

(1) Diameter 8x4 inches.

(2) Total Depth 1171 feet.

(3) Water Level 25 feet below top of ground.
709' 4"

(4) Cased to 421' Size 8"
22' Lap

(5) Screen: Size 4" Length 55'
7' of 4" Blank
1' 5" of 8x4 swage

(6) Were any formations sealed against pollution?
yes yes, no.


If YES depth of formation Lead seal,
cemented casing & lead shot.
Why

Drillers Remarks:

Yield in gpm:

Size pump:

Type power:

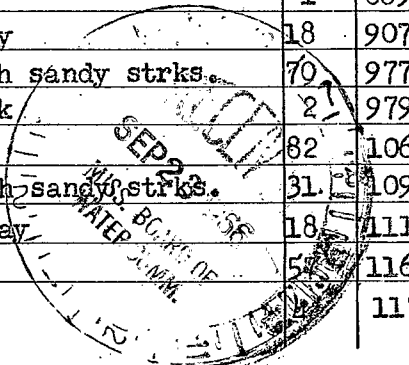

Mail this copy to Board of Water Commissioners 429 Miss. St. Jackson, Miss.

