

WASH.
K17
7-7-61

WATER WELL DRILLERS LOG

7/19/61
Jm
R 301

Date: July 7, 1961, Driller: Layne-Central Company County Washington

(Name)

Depth Thickness

(1) Owner of Land: M. G. Johnson
(Name)

Description & Color of Materials
Sand, Clay, Red Clay, Shell, etc.

Wahrton, Texas
(Address)

Clay 35 35

(2) Location: 1/4, 1/4, Sec. 22 T R

Coarse sand, clay balls 49 11

2 miles southeast, of Avon
(distance) (direction) (Nearest Town)

Coarse sand 58 9

(3) Topography: flat
(Hilly) (Flat) (Level)

Coarse sand, pea gravel 92 34

(4) Purpose of Well: irrigation
(Domestic Irrigation
Municipal, Industrial, Other)

Big rocks 102 10

Big gravel 112 10

Pea and big gravel 126 14

Clay 137 11

Information upon completion of well:

(1) Diameter 24 inches.

(2) Total Depth 126 feet.

(3) Water Level 13' 8" feet below top of ground.

(4) Cased to 61' 5", Size 24"
16" 4' 7"


(5) Screen: Size 16", Length 60'

(6) Were any formations sealed against pollution?
yes, X no.

If YES depth of formation

Why

Drillers Remarks:

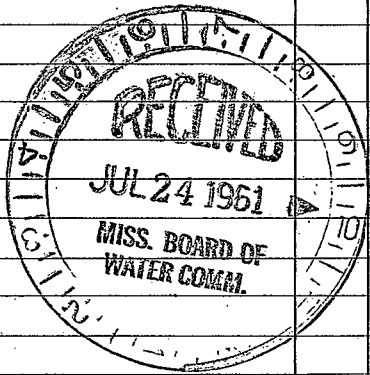

Well No.

(Use Back Side)

