

WASH.

K18

7-22-61

WATER WELL DRILLERS LOG

**CODED**

K 300


Date: 7/22, 1961, Driller: Bailey Drilling Co. County Washington  
 (Name)

(1) Owner of Land: Baptist Church  
 (Name)  
James  
 (Address) 26 168  
 (2) Location: NW 1/4, SW 1/4, Sec. 16  
at James  
 miles of  
 (distance) (direction) (Nearest Town)  
 (3) Topography: Flat  
 (Hilly) (Flat) (Level)  
 (4) Purpose of Well: domestic  
 (Domestic Irrigation  
 Municipal, Industrial, Other)

Description & Color of Materials Sand, Clay, Red Clay, Shell, etc.	Thick- ness Feet	Depth Feet
<u>Clay</u>	<u>14</u>	<u>14</u>
<u>Sand</u>	<u>26</u>	<u>50</u>
<u>Gravel &amp; Sand</u>	<u>58</u>	<u>108</u>
<u>Mud</u>	<u>128</u>	<u>236</u>
<u>Fine Sand</u>	<u>10</u>	<u>246</u>
<u>Hard place</u>	<u>2</u>	<u>248</u>
<u>Dark Sand</u>	<u>37</u>	<u>285</u>
<u>Hard place</u>	<u>2</u>	<u>287</u>
<u>Sand</u>	<u>23</u>	<u>310</u>

Information upon completion of well:

(1) Diameter 2 1/2 x 2 inches.  
 (2) Total Depth 305 feet.  
 (3) Water Level 14 feet below top of ground.  
 (4) Cased to all way, Size 2 1/2 x 2.  
 (5) Screen: Size 2, Length 10 ft.  
 (6) Were any formations sealed against pollution?  
 \_\_\_\_\_ yes, X no.

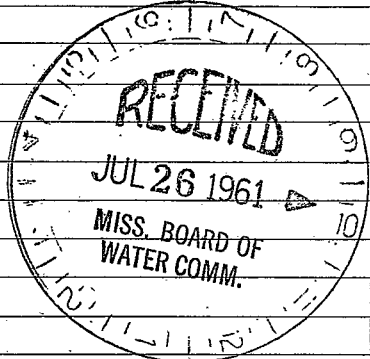

**CODED**

If YES depth of formation \_\_\_\_\_  
 Why \_\_\_\_\_  
 Drillers Remarks: \_\_\_\_\_  
 \_\_\_\_\_  
 \_\_\_\_\_

(Use Back Side)

Well No.

1950