

K 22

4-3-64

WATER WELL DRILLERS LOG

CODED

Date: 4/3, 1964, Driller: Bailey Drlg. Co. County: Washington (Name)

(1) Owner of Land: Albert Wolfe
 (Name)
Wayside, Miss.
 (Address)

(2) Location: 1/4, 1/4, Sec. 1 T. 16 R. 8
at wayside
 miles (distance) of (direction) (Nearest Town)

(3) Topography: Flat
 (Hilly) (Flat) (Level)

(4) Purpose of Well: domestic
 (Domestic Irrigation
 Municipal, Industrial, Other)

Description & Color of Materials Sand, Clay, Red Clay, Shell, etc.	Thick- ness Feet	Depth Feet
<u>Mud</u>		<u>300</u>
<u>Rock</u>		<u>301</u>
<u>Mud</u>		<u>330</u>
<u>Mud & Sand</u>		<u>360</u>
<u>Sand</u>		<u>475</u>

Information upon completion of well:

(1) Diameter: 2 1/2 x 7 inches.

(2) Total Depth: 475 feet.

(3) Water Level: 23 feet below top of ground.

(4) Cased to: all way Size: 2 1/2 x 7

(5) Screen: Size 2; Length 10ft.


(6) Were any formations sealed against pollution?
 _____ yes, X no.

CODED

If YES depth of formation _____

Why _____

Drillers Remarks: _____

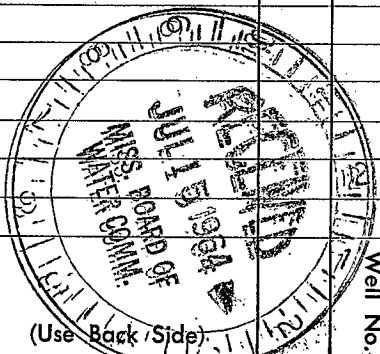

Well No.

(Use Back Side)

