

WASH.

K23

4-3-64

WATER WELL DRILLERS LOG

**CODED** 15

Date: 4/3, 1964, Driller: Bailey Drilg. Co. County Washington  
 (Name)

(1) Owner of Land: Grady Osburn  
 (Name)  
Nayside, Miss.  
 (Address)

(2) Location: 1/4, 1/4, Sec. 1 T16R8  
at Nayside  
 miles of (distance) (direction) (Nearest Town)

(3) Topography: Flat  
 (Hilly) (Flat) (Level)

(4) Purpose of Well: Domestic  
 (Domestic Irrigation  
 Municipal, Industrial, Other)

Description & Color of Materials Sand, Clay, Red Clay, Shell, etc.	Thick- ness Feet	Depth Feet
<u>Mud</u>		<u>300</u>
<u>Rock</u>		<u>301</u>
<u>Mud</u>		<u>330</u>
<u>Mud + Sand</u>		<u>360</u>
<u>Sand</u>		<u>425</u>

Information upon completion of well:

(1) Diameter 2 1/2 x 1 inches.

(2) Total Depth 425 feet.

(3) Water Level 23 feet below top of ground.

(4) Cased to all way Size 2 1/2 x 2


(5) Screen: Size 2", Length 10 ft.

(6) Were any formations sealed against pollution?  
 \_\_\_\_\_ yes, X no.

If YES depth of formation \_\_\_\_\_

Why \_\_\_\_\_

Drillers Remarks: \_\_\_\_\_

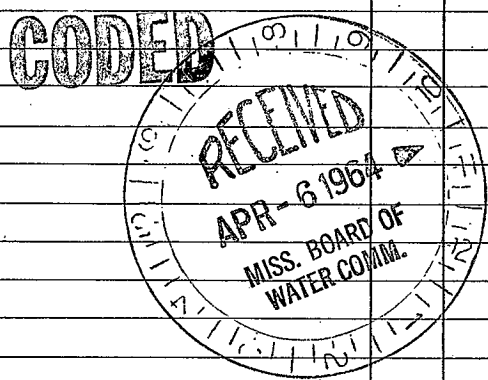

Well No.

(Use Back Side)

1954