

6/5/67  
 Jm  
 2455

Washington  
 K24  
 5-67  
 Electric Log

MISSISSIPPI  
 BOARD OF WATER COMMISSIONERS  
 416 North State Street  
 Jackson, Mississippi 39201

WATER WELL DRILLERS LOG

May 16, 19 67 Layne-Central Company Washington  
 date well completed firm name county well located

LANDOWNER: Anchem Products, Inc

description of formations encountered	from	to
	Clay	0
Coarse sand	7	21
Fine sand	21	32
Coarse sand	32	45
Coarse sand, pea gravel	45	98
Coarse sand, gravel, big boulders	98	101
Clay, pink, hard		101

Greenville, Mississippi

Ambler, Pennsylvania  
 (mailing address)


WELL LOCATION:  
 sec. 2 T. 16 N. R. 8 E. Miss.  
 S W  
 1 miles south of Wayside,  
 (distance) (direction) (nearest town)

WELL PURPOSE: irrigation  
 (home, irrigation, municipal, industrial)

WELL COMPLETION DATA:

- (1) diameter (inches) 10
- (2) total depth (feet) 101
- (3) static water level (feet) 22' 1" <sup>max</sup> above top of ground.
- (4) casing steel, 61' (material), (depth), 10" (size) if telescope see back.
- (5) screen 40' (length), 101' (depth to top), 10" (size), Armco (material)
- (6) pump 50 (HP), 750 @ 70# (yield gpm), electric (type power)
- (7) electric log no (yes or no), (organization running log)
- (8) how well bottom plugged plate


DRILLERS REMARKS:

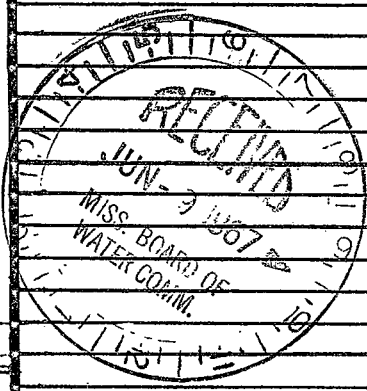

If well telescopes please sketch and show depths.

Lots 4 & 5

GROUND LEVEL

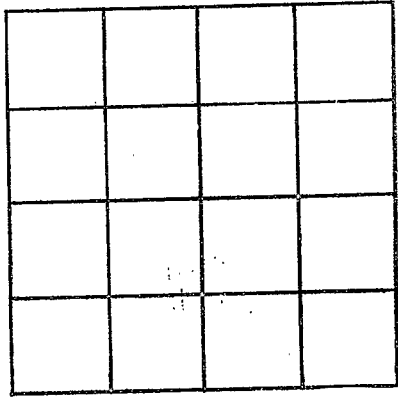

SECTION \_\_\_\_\_

Please indicate well location X.

ADDITIONAL INFORMATION

A series of horizontal lines providing space for additional information, starting below the 'ADDITIONAL INFORMATION' header.

If more than one screen, show locations of each on sketch.