

Washington
K 25
5-67

MISSISSIPPI
BOARD OF WATER COMMISSIONERS
416 North State Street
Jackson, Mississippi 39201
WATER WELL DRILLERS LOG

7/3/67
Jas
2455


May 16, 1967 Layne-Central Company Washington
date well completed firm name county well located

LANDOWNER: Amchem Products, Inc
Wayside, Mississippi
Ambler, Pennsylvania
(mailing address)
WELL LOCATION:
sec. 2 T N R E
S W
1 miles south of Wayside
(distance) (direction) (nearest town)

Description of formations encountered	from	to
Clay	0	7
Coarse sand	7	21
Fine sand	21	32
Coarse sand	32	45
Coarse sand, pea gravel	45	98
Coarse sand, gravel & big boulders	98	101
Clay, pink, hard		101

WELL PURPOSE: irrigation
(home, irrigation, municipal, industrial)


WELL COMPLETION DATA:
(1) diameter (inches) 10
(2) total depth (feet) 101
(3) static water level (feet) 22' 1" below ~~max~~ top of ground.
(4) casing steel, 61'
(material) (depth)
10" if telescope see back.
(size)
(5) screen 40', 101'
(length) (depth to top)
10", Armco
(size) (material)
(6) pump 50, 995
(HP) (yield gpm)
electric
(type power)
(7) electric log no
(yes or no)
(organization running log)
(8) how well bottom plugged plate

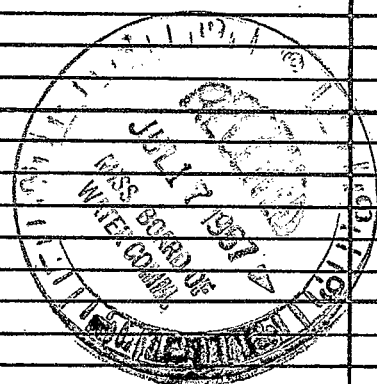

DRILLERS REMARKS:

If well telescopes please sketch and show depths.

GROUND LEVEL

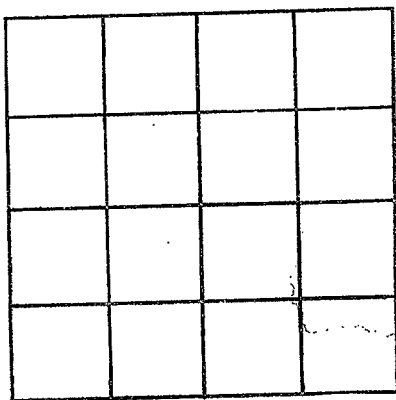

SECTION _____

Please indicate well location X.

ADDITIONAL INFORMATION

If more than one screen, show locations of each on sketch.