

WASH.
K26
8-24-61

302

WATER WELL DRILLERS LOG

K 12

Date: 8/24, 1961, Drilled by Pailey Drilling Co County Washington
(Name)

(1) Owner of Land Wayside Well Co
(Name)
Wayside, Miss.
(Address)

(2) Location: 1/4, 1/4, Sec. 1 T. R,
at wayside
miles (distance) of (direction) (Nearest Town)

(3) Topography: Flat
(Hilly) (Flat) (Level)

(4) Purpose of Well: domestic
(Domestic Irrigation
Municipal, Industrial, Other)

Description & Color of Materials Sand, Clay, Red Clay, Shell, etc.	Thick- ness Feet	Depth Feet
<u>Clay</u>	<u>2</u>	<u>2</u>
<u>Sandy Soil</u>	<u>23</u>	<u>25</u>
<u>Mud</u>	<u>221</u>	<u>246</u>
<u>Sand (not good)</u>	<u>12</u>	<u>258</u>
<u>Mud</u>	<u>102</u>	<u>360</u>
<u>Sand</u>	<u>70</u>	<u>430</u>
<u>6" Rock at 300</u>		
<u>12" " at 346</u>		

Information upon completion of well:

(1) Diameter 4x2 inches.

(2) Total Depth 420 feet.

(3) Water Level 22 feet below top of ground.

(4) Cased to all way Size 4x2


(5) Screen: Size 2", Length 30ft

(6) Were any formations sealed against pollution?
 yes, no.

If YES depth of formation _____

Why _____

Drillers Remarks: _____

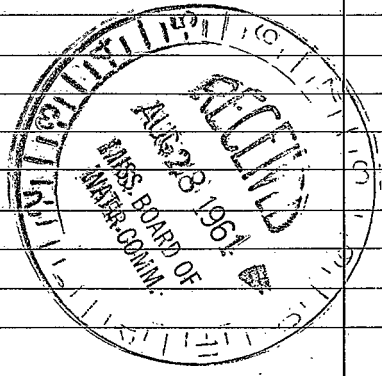

(Use Back Side)

Well No.

