

WASH.

MISSISSIPPI BOARD OF WATER COMMISSIONERS

CODED

K28

WATER WELL DRILLERS LOG

5-10-63

Date: 5/10, 1963, Driller: Auley Drlg Co County: Washington
(Name)

(1) Owner of Land: Don Coleman
(Name)

Wayside, Miss
(Address)

(2) Location: 1/4, 1/4; Sec. 2 16R8

1 1/2 miles South, of Wayside
(distance) (direction) (Nearest Town)

(3) Topography: Flat
(Hilly) (Flat) (Level)

(4) Purpose of Well: Domestic
(Domestic Irrigation
Municipal, Industrial, Other)

Description & Color of Materials
Sand, Clay, Red Clay, Shell, etc.

Thick-
ness
Feet

Depth
Feet

Clay
Sand

15
67

CODED

Information upon completion of well:

(1) Diameter 3x2 inches.

(2) Total Depth 67 feet.

(3) Water Level 12 feet below top of ground.

(4) Cased to all way Size 3

(5) Screen: Size 2, Length 5 ft


(6) Were any formations sealed against pollution?

X yes, X no.

If YES depth of formation _____

Why _____

Drillers Remarks: _____

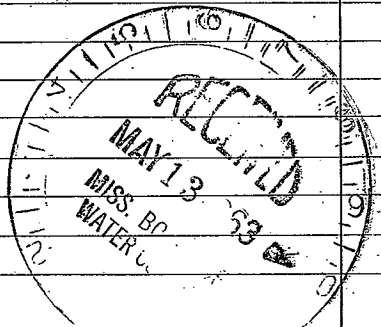

(Use Back Side)

Well No.

