

Washington

MISSISSIPPI BOARD OF WATER COMMISSIONERS

K 31

9-66

WATER WELL DRILLERS LOG

Date: 9/29, 1966, Driller: Bailey Drlg Co, County: Washington
PO Box 5335, Greenville, Miss

(1) Owner of Land: Wayside Well Co
 (Name)
Wayside, Miss.
 (Address)

(2) Location: SW 1/4, SW 1/4, Sec. 5, T16N, R8W
 at Wayside of _____
 (distance) (direction) (Nearest Town)

(3) Topography: Flat
 (Hilly) (Flat) (Level)

(4) Purpose of Well: Domestic
 (Domestic Irrigation
 Municipal, Industrial, Other)

Description & Color of Materials Sand, Clay, Red Clay, Shell, etc.	Thick- ness Feet	Depth Feet
Sandy soil	27	27
Mud	219	246
fine sand	12	258
Mud	42	300
Rock	1/2	300 1/2
Mud	45 1/2	346
Rock	1	347
Mud	13	360
Sand	60	420

Information upon completion of well:

(1) Diameter ~~4~~ 2 inches.

(2) Total Depth 420 feet.

(3) Water Level 22 feet below top of ground.

(4) Cased to all ways Size _____

(5) Screen: Size 3", Length 30'


(6) Were any formations sealed against pollution?

yes, no.

If YES depth of formation _____
Why _____

Drillers Remarks: _____

* NE, NW, Sec 1, T16N, R8W (usgs)

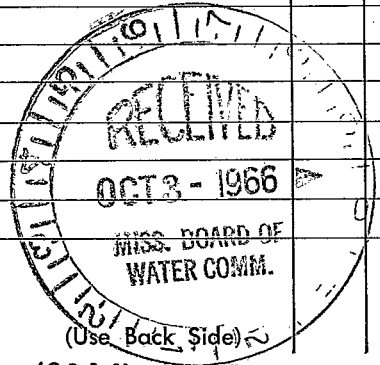

Well No.

[The page contains extremely faint and illegible text, likely bleed-through from the reverse side of the document. No specific words or phrases can be transcribed.]