

WASH.
K 35
8-16-65

MISSISSIPPI BOARD OF WATER COMMISSIONERS

CODED

WATER WELL DRILLERS LOG

Date: 8/16, 1965, Driller: Bailey Drilling Co. County Washington
(Name)

(1) Owner of Land:	Description & Color of Materials Sand, Clay, Red Clay, Shell, etc.	Thick- ness Feet	Depth Feet
<u>Larce Mitchell</u> (Name)	<u>Clay</u>		<u>30</u>
<u>Wayside, Miss.</u> (Address)	<u>Sand</u>		<u>70</u>
(2) Location: <u>13 16N 8W</u> <u>1/4</u> , <u>1/4</u> , Sec. <u>T R</u>	<u>Gravel</u>		<u>77</u>
<u>3</u> miles <u>SE</u> of <u>Wayside</u> (distance) (direction) (Nearest Town)	<u>Mud</u>		<u>160</u>
(3) Topography: <u>Flat</u> (Hilly) (Flat) (Level)	<u>Rock</u>		<u>161</u>
(4) Purpose of Well: <u>Domestic</u> (Domestic Irrigation Municipal, Industrial, Other)	<u>Mud</u>		<u>300</u>
	<u>Sand</u>		<u>368</u>
	<u>Mud</u>		<u>371</u>
	<u>Sand</u>		<u>428</u>
	<u>Mud</u>		<u>440</u>
	<u>Sand</u>		<u>466</u>


Information upon completion of well:

- (1) Diameter 2 inches.
- (2) Total Depth 466 feet.
- (3) Water Level 26 feet below top of ground.
- (4) Cased to all way size 2
- (5) Screen: Size 2", Length 5 ft.
- (6) Were any formations sealed against pollution?
_____ yes, X no.

Inst. in
to locate

CODED

If YES depth of formation _____
Why _____
Drillers Remarks: _____

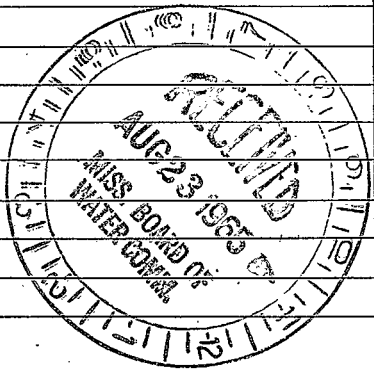

(Use Back Side)

Well No.

