

K 36

11-26-65

WATER WELL DRILLERS LOG

CODED

Date: 11/26, 1965, Driller: Bailey Drlg. Co. County: Washington
 (Name)

(1) Owner of Land:	Description & Color of Materials Sand, Clay, Red Clay, Shell, etc.	Thick- ness Feet	Depth Feet
<u>Sophia Johnson</u> (Name)	<u>Clay</u>		<u>30</u>
<u>Wayside, Miss.</u> (Address)	<u>Sand</u>		<u>70</u>
(2) Location: <u>1/4, 1/4, Sec. 13 16N8W</u>	<u>Gravel</u>		<u>86</u>
<u>4</u> miles <u>SE</u> of <u>Wayside</u>	<u>Mud</u>		<u>308</u>
(distance) (direction) (Nearest Town)	<u>Rock</u>		<u>308 1/2</u>
(3) Topography: <u>Flat</u>	<u>Mud</u>		<u>338</u>
(Hilly) (Flat) (Level)	<u>Sand</u>		<u>349</u>
(4) Purpose of Well: <u>Domestic</u>	<u>Mud</u>		<u>410</u>
(Domestic Irrigation Municipal, Industrial, Other)	<u>Sand</u>		<u>450</u>

Information upon completion of well:

- (1) Diameter 2 inches.
- (2) Total Depth 450 feet.
- (3) Water Level 25 feet below top of ground.
- (4) Cased to all way Size 2
- (5) Screen: Size 2, Length 5 ft.
- (6) Were any formations sealed against pollution?
 _____ yes, X no.


CODED

Insuff. info
to locate

If YES depth of formation _____

Why _____

Drillers Remarks: _____

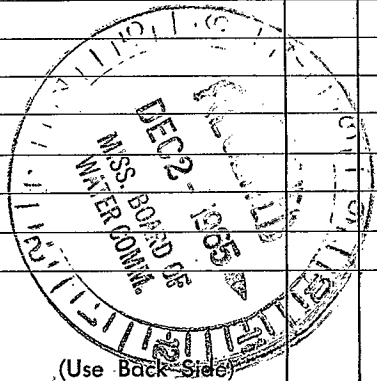

Elev ± (2)

(Use Back Side)

Well No.

[The page contains extremely faint and illegible text, likely bleed-through from the reverse side of the document. No specific content can be transcribed.]