

K 39

2-16-63

WATER WELL DRILLERS LOG

CODED

Date: 2/16, 1963, Driller: Bailey Drlg Co.

County: Washington

(1) Owner of Land: WCSkates
 (Name)
Avon, Miss.
 (Address)

(2) Location: 27 16 N 8 W
 1/4, 1/4, Sec. T R
3 miles SE of Avon
 (distance) (direction) (Nearest Town)

(3) Topography: Flat
 (Hilly) (Flat) (Level)

(4) Purpose of Well: Farm
 (Domestic Irrigation
 Municipal, Industrial, Other)

Description & Color of Materials Sand, Clay, Red Clay, Shell, etc.	Thick- ness Feet	Depth Feet
Clay		8
Sand		45
Gravel		110
Mud		138
Rock		141
Mud		160
Rock		160 1/2
Mud		339
Sand + Mud		365
Mud		414
Sand	11	425
Mud	6	431
Sand		430
CODED Sand	117	548
Mud	182	730
Sand	119	849
Mud	67	916
Rock		917
Mud		962
Sand		1000
Mud		1008
Rocks		1013
Mud		1018
Sand		1068

Information upon completion of well:

(1) Diameter 4 X 2 inches.

(2) Total Depth 1068 feet.

(3) Water Level 19 1/2 feet below top of ground.

(4) Cased to all way Size 4 X 2


(5) Screen: Size 2, Length 20 ft

(6) Were any formations sealed against pollution?
 _____ yes, X no.

If YES depth of formation _____

Why _____

Drillers Remarks: _____

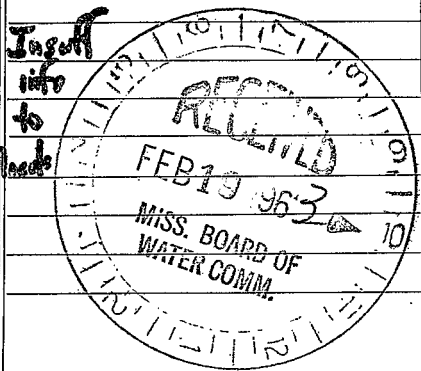

(Use Back Side)

Well No.

