

WASH.

MISSISSIPPI BOARD OF WATER COMMISSIONERS

K-40

Ans info to locate ?

WATER WELL DRILLERS LOG

CODED

7-25-61

Date: 7/25, 1961, Driller: Bailey & Co. (Name)

CODED
County: Washington

(1) Owner of Land: J E Bratton
(Name)
James
(Address)

(2) Location: 1/4, 1/4, Sec. 29 16N 8W
east of James
(distance) (direction) (Nearest Town)

(3) Topography: Flat
(Hilly) (Flat) (Level)

(4) Purpose of Well: domestic
(Domestic Irrigation
Municipal, Industrial, Other)

Description & Color of Materials Sand, Clay, Red Clay, Shell, etc.	Thick- ness Feet	Depth Feet
Clay	40	40
Sand	40	80
Wood	2	82
Gravel & Sand	10	92
Mud	82	174
Fine Sand	21	195
Dark Sand	41	236
Light Sand	41	277

Information upon completion of well:

(1) Diameter: 3 X 2 inches.


(2) Total Depth: 270 feet.

(3) Water Level: 13 feet below top of ground.

(4) Cased to all way Size 3 X 2
2"

(5) Screen: Size #, Length 10ft.

(6) Were any formations sealed against pollution?
_____ yes, X no.

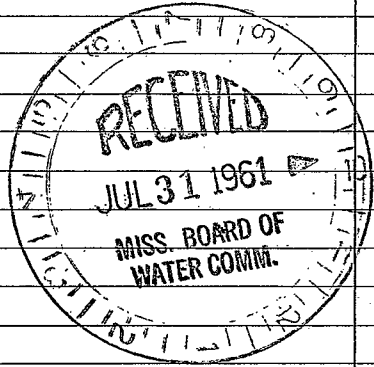

CODED
Insert info
to locate

If YES depth of formation _____

Why _____

Drillers Remarks: _____

(Use Back Side)

Well No.

