

Washington
 K 45
 2-5-70

MISSISSIPPI
 BOARD OF WATER COMMISSIONERS
 416 North State Street
 Jackson, Mississippi 39201
 WATER WELL DRILLERS LOG

ltn 3/17/70
 land bank 4-16-70
 3/1/70
 COPIED
 0090

February 5, 1970 Layne-Central Company Washington
 date well completed firm name county well located

LANDOWNER: V. C. Hammett, Jr.	description of formations encountered	from	to
	Clay	0	49
	Sand with some clay	49	55
Greenville, Mississippi	Sand and gravel	55	76
(mailing address)	White clay	76	

WELL LOCATION:

sec. 18 T-16 N R-8 W
 7 miles SE of Wayside
 (distance) (direction) (nearest town)

WELL PURPOSE: irrigation
 (home, irrigation, municipal, industrial)

WELL COMPLETION DATA:

- (1) diameter (inches) 12
- (2) total depth (feet) 76
- (3) static water level (feet) 17' below top of ground.
- (4) casing steel, 56' (material), (depth)
 12" (size) if telescope see back.
- (5) screen 20' (length), 76' (depth to top)
 12" (size), Armco (material)
- (6) pump 10 (HP), 750 (yield gpm)
 electric (type power)
- (7) electric log no (yes or no)
 (organization running log)
- (8) how well bottom plugged plate


DRILLERS REMARKS:

COPIED

MAR 16 1970
 MISS. Bd. OF WATER COM.

If well telescopes please
sketch and show depths.

GROUND LEVEL

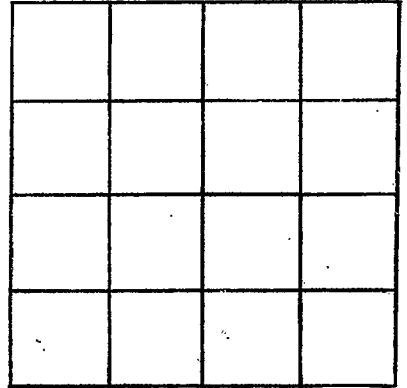

SECTION _____

Please indicate well location X.

ADDITIONAL INFORMATION

If more than one screen,
show locations of each on sketch.