

WASHINGTON

K 46

5-19-70

MISSISSIPPI
 BOARD OF WATER COMMISSIONERS
 416 North State Street
 Jackson, Mississippi 39201

INDEXED

WATER WELL DRILLERS LOG

5-19-70 19
date well completed

argo drilling co.
firm name

Washington
county well located

LANDOWNER:

W. E. Scate

Greenwell, Mrs.
(mailing address)

WELL LOCATION:

sec. 10 T 16 N R 8 E
3 miles East of Mayfield
(distance) (direction) (nearest town)

WELL PURPOSE: Irrigation
(home, irrigation, municipal, industrial)

WELL COMPLETION DATA:

- (1) diameter (inches) 16"
- (2) total depth (feet) 84'
- (3) static water level (feet) 12' below top of ground.
- (4) casing 4" galvanized (material), 57' (depth)
16" (size) if telescope see back.
- (5) screen 32' (length), 52" (depth to top)
16" (size), Black Iron (material)
- (6) pump 10 (HP), approx 1800 (yield gpm)
Electric (type power)
- (7) electric log no. (yes or no)
no. (organization running log)
- (8) how well bottom plugged 1/2" steel plate

description of formations encountered

from to

clay	0	12'
fine sand	12	45'
medium sand	45	50'
fine gravel	50	82'
blue clay	80	

INDEXED


JUN 11 1970

DRILLERS REMARKS:

MISS. DIV. OF
WATER COMM.

If well telescopes please sketch and show depths.

GROUND LEVEL

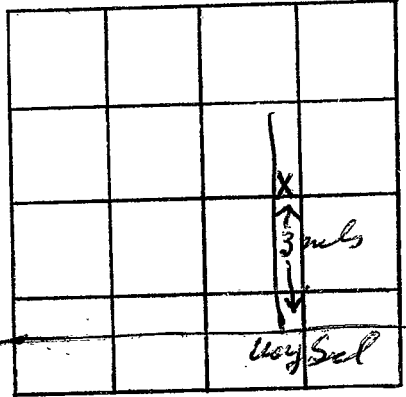

SECTION _____

Please indicate well location X.

ADDITIONAL INFORMATION

well located
on Hi 438 3 well
~~west of~~ East
of Hi 1 south of
Grenada

If more than one screen,
show locations of each on sketch.