

WASHINGTON  
K 47  
9-9-70

MISSISSIPPI  
BOARD OF WATER COMMISSIONERS  
416 North State Street  
Jackson, Mississippi 39201

**CODED**

WATER WELL DRILLERS LOG

9/9 1970 Bailey Drlg. Co. Washington  
date well completed firm name county well located

LANDOWNER: W. A. Branton  
Greenville, Miss.

description of formations encountered	from	to
<u>Clay</u>	<u>0</u>	<u>60</u>
<u>Silt</u>	<u>60</u>	<u>72</u>
<u>Mud + gravel</u>	<u>72</u>	<u>80</u>
<u>Sand</u>	<u>80</u>	<u>90</u>

(mailing address)

WELL LOCATION:  
sec. 28 T. 16 N. R. 8 E  
5 miles SE of Avon  
(distance) (direction) (nearest town)

WELL PURPOSE: Home  
(home, irrigation, municipal, industrial)

- WELL COMPLETION DATA:
- (1) diameter (inches) 2
  - (2) total depth (feet) 90
  - (3) static water level (feet) 16 below above top of ground.
  - (4) casing steel, 86,  
(material) (depth)  
2" if telescope see back.  
(size)
  - (5) screen 4', 86  
(length) (depth to top)  
2", Brass  
(size) (material)
  - (6) pump 1/2, 5  
(HP) (yield gpm)  
Elec  
(type power)
  - (7) electric log No  
(yes or no)

**CODED**

(organization running log)

(8) how well bottom plugged Back pressure valve


SEP 14 1970

DRILLERS REMARKS:

MISS. BD. OF  
WATER COMM.

If well telescopes please sketch and show depths.

GROUND LEVEL

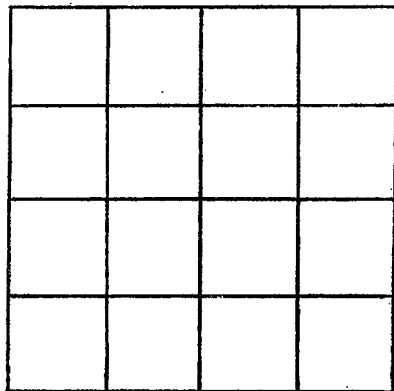

SECTION \_\_\_\_\_

Please indicate well location X.

ADDITIONAL INFORMATION

If more than one screen, show locations of each on sketch.