

WASHINGTON
K 50
10-16-72

MISSISSIPPI
BOARD OF WATER COMMISSIONERS
416 North State Street
Jackson, Mississippi 39201

CODED

WATER WELL DRILLERS LOG

10-16 1972 Bailey Drilling Co Washington
date well completed firm name county well located

LANDOWNER: Willie Lee Perry
Greenville
Miss.
(mailing address)

description of formations encountered	from	to
Clay	0	20
Sand	20	65
Gravel	65	70
Mud	70	220
Rock	220	220 1/2
Mud	220 1/2	258
Rock	258	259
Mud	259	340
Mud & Sand	340	380
Sand	380	421

WELL LOCATION:
sec. 12 T. 16 N R. 8 E
10 miles SE of Greenville
(distance) (direction) (nearest town)

WELL PURPOSE: Home
(home, irrigation, municipal, industrial)

WELL COMPLETION DATA:

- (1) diameter (inches) 3 X 2
- (2) total depth (feet) 421
- (3) static water level (feet) 25 below top of ground.
- (4) casing Steel, 413 (material), (depth)
3 X 2 (size) if telescope see back.
- (5) screen 8' 413 (length), (depth to top)
2" Stainless Steel (size), (material)
- (6) pump 1 10 (HP), (yield gpm)
Elec (type power)
- (7) electric log NO (yes or no)

CODED

(organization running log)

(8) how well bottom plugged Back pressure valve


OGI 18 1972

DRILLERS REMARKS:

REG. NO. OF
LICENSED ADDRESS
DRILLERS

If well telescopes please
sketch and show depths.

GROUND LEVEL

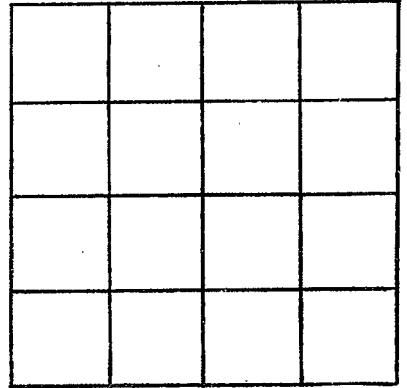

SECTION _____

Please indicate well location X.

ADDITIONAL INFORMATION

If more than one screen,
show locations of each on sketch.