

Washington  
K S  
4-28-75

MISSISSIPPI  
BOARD OF WATER COMMISSIONERS  
416 North State Street  
Jackson, Mississippi 39201

CODED

WATER WELL DRILLERS LOG

*Senger - Rayne*  
Hobart Farms

April 28, 19 75 date well completed  
Hobart Farms firm name  
Washington county well located


LANDOWNER: C. E. Hobart Avon, Miss. (mailing address)	description of formations encountered	from	to
	Medium Sand	32	42'
	Coarse Sand & Gravel	42	81'
WELL LOCATION: 15I sec. 20 T 16 N R 8 E & W 5 miles East of Avon (distance) (direction) (nearest town)			
WELL PURPOSE: irrigation (home, irrigation, municipal, industrial)			
WELL COMPLETION DATA:			
(1) diameter (inches) 16"			
(2) total depth (feet) 81'			
(3) static water level (feet) 2 below top of ground. above.			
(4) casing Steel 41' (material) (depth) 16" if telescope see back. (size)			
(5) screen 40' 40' (length) (depth to top) 16" Steel (size) (material)			
(6) pump 30 400-800 (HP) (yield gpm) engine (type power)			
(7) electric log no (yes or no) (organization running log)			
(8) how well bottom plugged steel plate			
DRILLERS REMARKS:			

REGISTERED  
LABORATORY  
JUL 14 1975

MISS. RD. OF WATER COMMISSIONERS

If well telescopes please sketch and show depths.

GROUND LEVEL

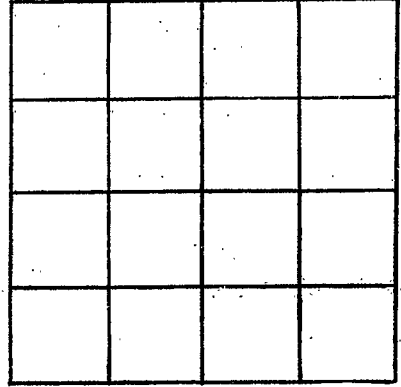

SECTION \_\_\_\_\_

Please indicate well location X.

ADDITIONAL INFORMATION

If more than one screen,  
show locations of each on sketch.