

WASH.
K56
7/13/77

MISSISSIPPI
BOARD OF WATER COMMISSIONERS
416 North State Street
Jackson, Mississippi 39201

CODED


WATER WELL DRILLERS LOG

7-13-1977 date well completed Layne Central Co. firm name Washington county well located

LANDOWNER: Machinery, Inc. Avon, MS	description of formations encountered	from	to
(mailing address)	Clay	0	20
#1 WELL LOCATION:	Fine Sand	20	28
sec. <u>23</u> T <u>16</u> N R <u>8</u> W <u>2</u> miles S of Avon (distance) (direction) (nearest town)	Coarse Sand gravel	28	101
WELL PURPOSE: Irrigation (home, irrigation, municipal, industrial)	Clay	101	
WELL COMPLETION DATA:	CODED		
(1) diameter (inches) <u>16"</u>			
(2) total depth (feet) <u>101</u>			
(3) static water level (feet) <u>19'</u> below top of ground.			
(4) casing <u>Steel</u> , <u>52'</u> (material) (depth)			
<u>16"</u> If telescope see back. (size)			
(5) screen <u>50'</u> , <u>51'</u> (length) (depth to top)			
<u>16"</u> , <u>St. Steel</u> (size) (material)			
(6) pump <u>60</u> , <u>2500</u> (HP) (yield gpm)			
<u>diesel</u> (type power)			
(7) electric log <u>No.</u> (yes or no)			
(organization running log)			
(8) how well bottom plugged <u>St. Plate</u>			
DRILLERS REMARKS:	RECEIVED MAR 14 1978 MISS. BD. OF WATER COM.		

If well telescopes please sketch and show depths.

GROUND LEVEL

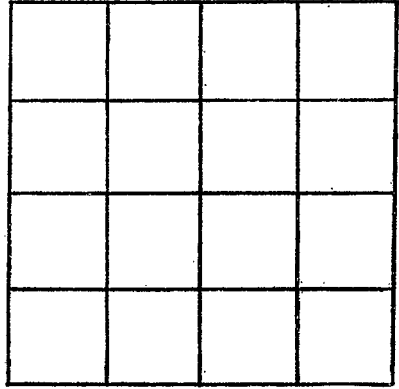

SECTION _____

Please indicate well location X.

ADDITIONAL INFORMATION

If more than one screen,
show locations of each on sketch.