

KASH.
 K57
 7/11/77

MISSISSIPPI
 BOARD OF WATER COMMISSIONERS
 416 North State Street
 Jackson, Mississippi 39201
WATER WELL DRILLERS LOG

7-11 19 77 Layne Central Co. Washington
 date well completed firm name county well located

LANDOWNER: Machinery, Inc.
 Avon, MS

description of formations encountered	from	to
Clay	0	41
Fine Sand	41	45
Med. Sand	45	49
Course Sand & Pea Gravel	49	94

(mailing address)

#3 WELL LOCATION:
 sec. 24 T 16 N R 8 W
 2 miles S of Avon
 (distance) (direction) (nearest town)

WELL PURPOSE: Irrigation
 (home, irrigation, municipal, industrial)

WELL COMPLETION DATA:

- (1) diameter (inches) 16"
- (2) total depth (feet) 84'
- (3) static water level (feet) 20' below top of ground.
- (4) casing Steel 61' (material), (depth)
16" (size) if telescope see back.
- (5) screen 30' 54' (length) (depth to top)
12" St. Steel (size) (material)
- (6) pump 60 2500 (HP) (yield gpm)
diesel (type power)
- (7) electric log No (yes or no)
(organization running log)
- (8) how well bottom plugged St. Plate

DRILLERS REMARKS:


RECEIVED

MAR 14 1978

MISSISSIPPI BOARD OF WATER COMMISSIONERS

If well telescopes please sketch and show depths.

GROUND LEVEL

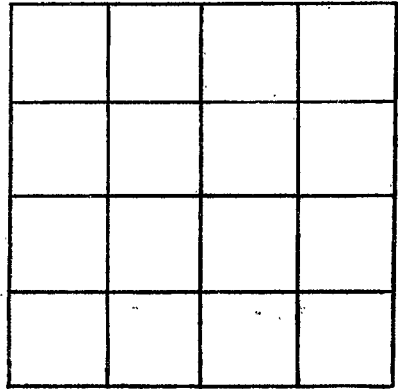

SECTION _____

Please indicate well location X.

ADDITIONAL INFORMATION

If more than one screen,
show locations of each on sketch.