

WASH.
K 58
7/13/77

MISSISSIPPI
BOARD OF WATER COMMISSIONERS
416 North State Street
Jackson, Mississippi 39201
WATER WELL DRILLERS LOG

CODED

7-13 19 77 Layne Central Co. Washington
date well completed firm name county well located

LANDOWNER: Machinery, Inc.
Avon, MS

description of formations encountered	from	to
Clay	0	8
Fine Sand	8	78
Coarse Sand & Pea Gravel	78	112

(mailing address)
#4 WELL LOCATION:
sec. 24 T. 16 N. R. 8 W
2 miles S of Avon
(distance) (direction) (nearest town)

WELL PURPOSE: Irrigation
(home, irrigation, municipal, industrial)

- WELL COMPLETION DATA:
- diameter (inches) 16"
 - total depth (feet) 112'
 - static water level (feet) 19' below top of ground.
 - casing Steel 80' (material) (depth)
16" (size) if telescope see back.
 - screen 35' 77' (length) (depth to top)
16" St. Steel (size) (material)
 - pump 60 2500 (HP) (yield gpm)
diesel (type power)
 - electric log No (yes or no)
(organization running log)
 - how well bottom plugged St. Plate


DRILLERS REMARKS:

CODED

RECEIVED
MAR 14 1978

If well telescopes please sketch and show depths.

GROUND LEVEL

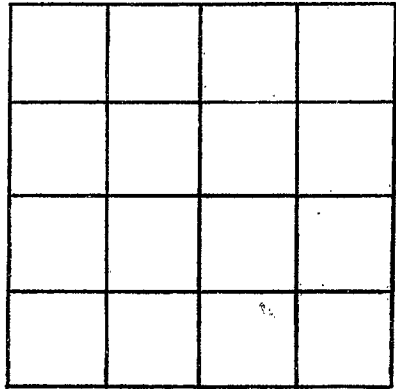

SECTION _____

Please indicate well location X.

ADDITIONAL INFORMATION

If more than one screen, show locations of each on sketch.