

WASH.
K 59
7/7/77

MISSISSIPPI
BOARD OF WATER COMMISSIONERS
416 North State Street
Jackson, Mississippi 39201
CODED
WATER WELL DRILLERS LOG

7-7 19 77 Lavne Central Co. Washington
date well completed firm name county well located

LANDOWNER:	description of formations encountered	from	to
Machinery, Inc. Avon, MS	Clay	0	38
(mailing address)	Fine Sand	38	45
#2 WELL LOCATION:	Coarse Sand & Gravel	45	100
sec. 23 T. 16 N R. 8 2 miles S of Avon (distance) (direction) (nearest town)			
WELL PURPOSE: Irrigation (home, Irrigation, municipal, industrial)			
WELL COMPLETION DATA:			
(1) diameter (inches) 16"			
(2) total depth (feet) 103'			
(3) static water level (feet) 22' below top of ground.			
(4) casing Steel 53' (material) (depth) 16" If telescope see back. (size)			
(5) screen 50' 53' (length) (depth to top) 16" St. Steel (size) (material)			
(6) pump 60 2500 (HP) (yield gpm) diesel (type power)			
(7) electric log No (yes or no)			
(organization running log)			
(8) how well bottom plugged St. Plate			
DRILLERS REMARKS:			


CODED

RECEIVED

MAR 14 1978
MAR 14 1978

If well telescopes please sketch and show depths.

GROUND LEVEL

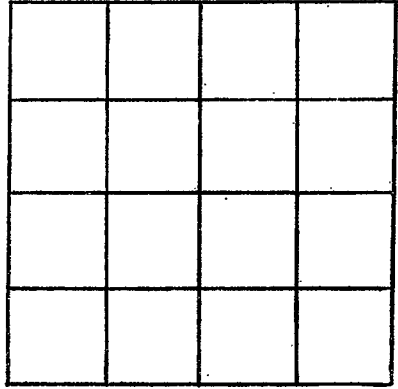

SECTION _____

Please indicate well location X.

ADDITIONAL INFORMATION

If more than one screen, show locations of each on sketch.