

WASHINGTON
K63
4-16-81

MISSISSIPPI
BOARD OF WATER COMMISSIONERS
416 North State Street
Jackson, Mississippi 39201

#2

WATER WELL DRILLERS LOG

4-16 date well completed 1981 Drisking & Assao firm name WASHINGTON county well located


LANDOWNER: E.A. Currey
Box 235
HOLLANDALE, MS 38748
(mailing address)

WELL LOCATION:
sec. 33 T 16 N R 8 E S W
9 miles (distance) (direction) of Hollandale (nearest town)

WELL PURPOSE: Irrigation
(home, irrigation, municipal, industrial)

- WELL COMPLETION DATA:
- (1) diameter (inches) 1 1/2"
 - (2) total depth (feet) 120'
 - (3) static water level (feet) 12' below top of ground.
 - (4) casing STEEL 87' (material) (depth)
1 1/2" if telescope see back. (size)
 - (5) screen 40" 87' (length) (depth to top)
1 1/2" STEEL (size) (material)
 - (6) pump 40 HP 1500 (HP) (yield gpm)
Diesel (type power)
 - (7) electric log NO (yes or no)
NO (organization running log)
 - (8) how well bottom plugged steel plug


description of formations encountered	CODED	from	to
Top Soil		0	5
Clay		5	10
MED & FINE SAND		10	15
"		15	20
MED & COARSE SAND		20	25
"		25	30
"		30	35
"		35	40
MED & COARSE SAND		40	45
MED & FINE SAND		45	50
"		50	55
MED & FINE SAND		55	60
"		60	65
MED & FINE SAND COAL		65	70
MED & COARSE SAND		70	75
COARSE SAND, GRAVEL COAL		75	80
COARSE SAND & GRAV.		80	85
"		85	90
"		90	95
"		95	100
"		100	105
"		105	110
"		110	115
Clay Bottom of Hole		115	120

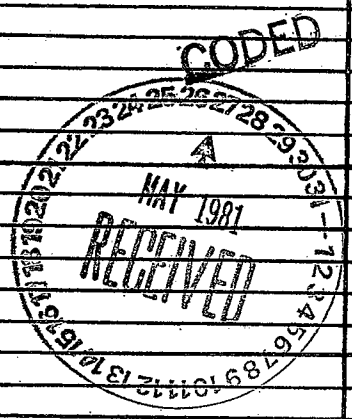

DRILLERS REMARKS:

If well telescopes please sketch and show depths.

GROUND LEVEL

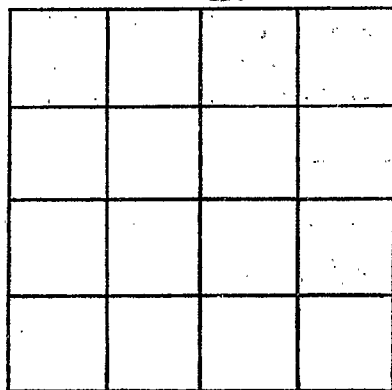

SECTION _____

Please indicate well location X.

ADDITIONAL INFORMATION

If more than one screen, show locations of each on sketch.