

Washington
K64
4-15-81

MISSISSIPPI
BOARD OF WATER COMMISSIONERS
416 North State Street
Jackson, Mississippi 39201

1

WATER WELL DRILLERS LOG

4-15 1981 DREILING & ASSOCIATES WASHINGTON
date well completed firm name county well located


LANDOWNER: E. A. CURRY
P.O. Box 235
HOLLANDALE, MS 38740
(mailing address)

WELL LOCATION:
sec. 3 T. 16 N. R. 8 E. S. 5 W.
9 miles W of Hollandale
(distance) (direction) (nearest town)

WELL PURPOSE: Drainage
(home, irrigation, municipal, industrial)

- WELL COMPLETION DATA:
- (1) diameter (inches) 12"
 - (2) total depth (feet) 104'
 - (3) static water level (feet) 12' below above top of ground.
 - (4) casing STEEL 104' 14'
(material) (depth)
(size) If telescope see back.
 - (5) screen 40' 64'
(length) (depth to top)
12" STEEL
(size) (material)
 - (6) pump 40 1500
(HP) (yield gpm)
Reisel
(type power)
 - (7) electric log NO
(yes or no)
NO
(organization running log)
 - (8) how well bottom plugged STEEL
plug


| description of fomations encountered | CODED | |
|--------------------------------------|-------|-----|
| | from | to |
| TOP SOIL | 0 | 5 |
| CLAY | 5 | 10 |
| " " | 10 | 15 |
| FINE SAND & CLAY | 15 | 20 |
| CLAY & FINE SAND | 20 | 25 |
| CLAY | 25 | 30 |
| " " | 30 | 35 |
| CLAY FINE SAND | 35 | 40 |
| FINE SAND | 40 | 45 |
| " " | 45 | 50 |
| MED & FINE SA | 50 | 55 |
| COURSE SAND & GRAV | 55 | 60 |
| " " | 60 | 65 |
| " " | 65 | 70 |
| " " | 70 | 75 |
| " " | 75 | 80 |
| " " | 80 | 85 |
| " " | 85 | 90 |
| " " | 90 | 95 |
| " " | 95 | 100 |
| Clay Bottom of Hole | 100 | 104 |

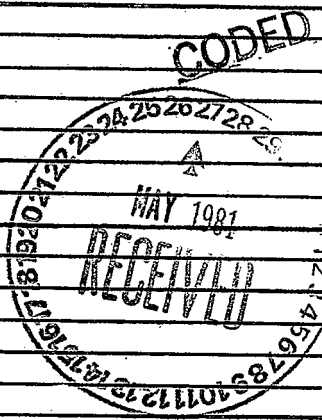

DRILLERS REMARKS:

If well telescopes please sketch and show depths.

GROUND LEVEL

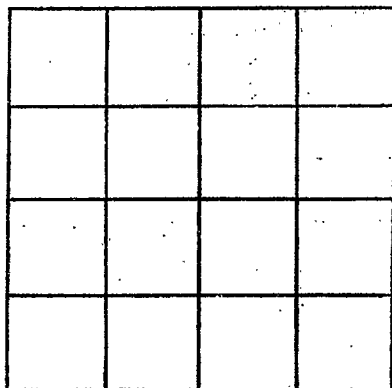

SECTION _____

Please indicate well location X.

ADDITIONAL INFORMATION

If more than one screen,
show locations of each on sketch.