

MISSISSIPPI DEPARTMENT OF NATURAL RESOURCES

Bureau of Land and Water Resources

Southport Mall

P.O. Box 10631

Jackson, Mississippi 39209

WATER WELL DRILLERS LOG

CODED

CL-1840
 Washington
 K65
 4-24-81

4-24-1981 date well completed 81 LAYNE-CENTRAL COMPANY firm name WASHINGTON county well located

LANDOWNER:	description of formations encountered	from	to
RAYMOND MURRELL			
AVON, MS	fine sand	43	51
(mailing address)	coarse sand	51	64
	coarse sand & gravel	64	84

WELL LOCATION:
 sec. 12 T 16 N R. 8 E
6 miles S.W. of ARCOLA
 (distance) (direction) (nearest town)

WELL PURPOSE: irrigation
 (home, irrigation, municipal, industrial)

WELL COMPLETION DATA:

(1) diameter (inches) 28"

(2) total depth (feet) 84'

(3) static water level (feet) 20'2" below above top of ground.

(4) casing steel 53'6'
 (material) (depth)
16"
 (size) if telescope see back.

(5) screen 30'6" 53'6"
 (length) (depth to top)
12" st. steel
 (size) (material)

(6) pump 40 1000
 (HP) (yield gpm)
DIESEL
 (type power)

(7) electric log no
 (yes or no)
 (organization running log)

(8) how well bottom plugged st. plate

DRILLERS REMARKS:


CODED

DEPT. OF NATURAL RESOURCES
 BUREAU OF LAND & WATER RESOURCES

OCT 20 1981
 RECEIVED

If well telescopes please sketch and show depths.

GROUND LEVEL

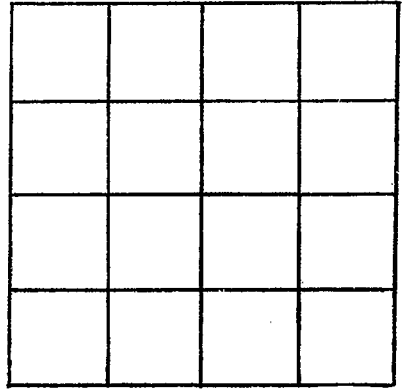

SECTION _____

Please indicate well location X.

ADDITIONAL INFORMATION

If more than one screen, show locations of each on sketch.