

MISSISSIPPI DEPARTMENT OF NATURAL RESOURCES

Bureau of Land and Water Resources

Southport Mall

P.O. Box 10631

Jackson, Mississippi 39209

WATER WELL DRILLERS LOG

CODED

Washington  
 CL-1961  
K 66  
7-13-81

7-13-81 19 LAYNE-CENTRAL CO. WASHINGTON  
 date well completed firm name county well located

LANDOWNER:	description of formations encountered	from	to
C. Allen Spragins, Jr.			
Greenville, MS	fine sand	19	22
(mailing address)	fine sand - clay	22	52
	c. sand - gravel	52	105

WELL LOCATION:  
 sec. 19 T. 16 N R. 8 E  
7 miles S-45° of ARCOLA  
 (distance) (direction) (nearest town)

WELL PURPOSE: Irrigation  
 (home, irrigation, municipal, industrial)

WELL COMPLETION DATA:

- (1) diameter (inches) 28"
- (2) total depth (feet) 104'
- (3) static water level (feet) 34' below above top of ground.
- (4) casing steel 64"  
 (material) (depth)  
12"  
 (size) if telescope see back.
- (5) screen 40' 64'  
 (length) (depth to top)  
12" s t. steel  
 (size) (material)
- (6) pump 20 1000  
 (HP) (yield gpm)  
electric  
 (type power)
- (7) electric log no  
 (yes or no)  
 (organization running log)
- (8) how well bottom plugged st. plate

CODED


DEPT. OF NATURAL RESOURCES  
 BUREAU OF LAND & WATER RESOURCES

RECEIVED  
 OCT 20 1981

DRILLERS REMARKS: \_\_\_\_\_

If well telescopes please sketch and show depths.

GROUND LEVEL

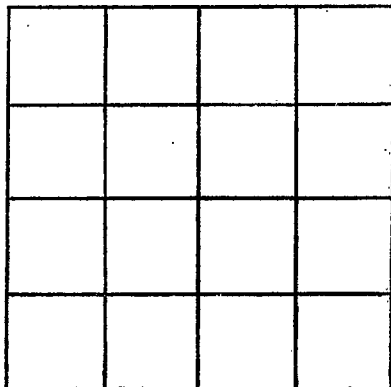

SECTION \_\_\_\_\_

Please indicate well location X.

ADDITIONAL INFORMATION

If more than one screen, show locations of each on sketch.