

WASHINGTON
K68
9-2-83

MISSISSIPPI DEPARTMENT OF NATURAL RESOURCES
Bureau of Land and Water Resources
Southport Mall
P.O. Box 10631
Jackson, Mississippi 39209
WATER WELL DRILLERS LOG

CODED

Sept 02 1983 date well completed
Larry's well & pump firm name
Washington county well located

LANDOWNER: <u>Driftwood Farms</u>	description of formations encountered	from	to
<u>Estelle, ms</u> (mailing address)	<u>clay</u>	<u>0</u>	<u>30</u>
	<u>Fine Sand</u>	<u>30</u>	<u>50</u>
	<u>Coarse Sand & gravel</u>	<u>50</u>	<u>116</u>
WELL LOCATION: sec. <u>29</u> T. <u>16</u> N. R. <u>8</u> E. S. W. <u>5</u> miles <u>west</u> of <u>Estelle</u> (distance) (direction) (nearest town)			
WELL PURPOSE: (home, irrigation, municipal, industrial)			
WELL COMPLETION DATA: (1) diameter (inches) <u>16'</u>			
(2) total depth (feet) <u>116'</u>			
(3) static water level (feet) <u>23</u> below top of ground.			
(4) casing <u>Steel</u> , <u>76'</u> (material) (depth)			
<u> </u> if telescope see back. (size)			
(5) screen <u>40'</u> , <u>76'</u> (length) (depth to top)			
<u>16"</u> , <u>Steel</u> (size) (material)			
(6) pump <u>60</u> , <u>3000</u> (HP) (yield gpm)			
<u>Electric</u> (type power)			
(7) electric log <u>NO</u> (yes or no)			
<u> </u> (organization running log)			
(8) how well bottom plugged <u>Steel Plate</u>			
DRILLERS REMARKS:			

CODED


MISSISSIPPI DEPARTMENT OF NATURAL RESOURCES
BUREAU OF LAND & WATER RESOURCES

FEB 15 1984

RECEIVED

If well telescopes please sketch and show depths.

GROUND LEVEL

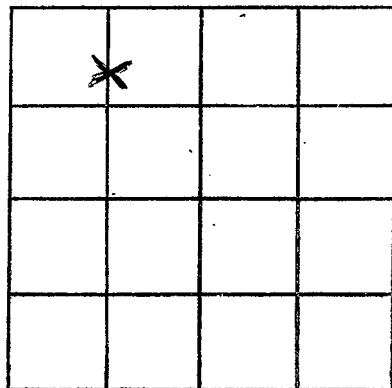

SECTION 29

Please indicate well location X.

ADDITIONAL INFORMATION

If more than one screen,
show locations of each on sketch.