

MISSISSIPPI DEPARTMENT OF NATURAL RESOURCES

Bureau of Land and Water Resources

Southport Mall

P.O. Box 10631

Jackson, Mississippi 39209

WATER WELL DRILLERS LOG

CODED

K 71
 Washington Co.
 11-13-84

Nov. 15, 1984 date well completed
 Dyer Well, Inc. firm name
 Washington county well located

LANDOWNER: <u>Leo Williams</u>	description of formations encountered	from	to
<u>Hollandale, Miss.</u> (mailing address)	<u>Clay</u> <u>Fine Sand</u> <u>Sand & Gravel</u>	<u>0</u> <u>38</u> <u>58</u>	<u>38</u> <u>58</u> <u>110</u>
WELL LOCATION: sec. <u>29</u> T. <u>16</u> N. R. <u>8</u> E <u>7</u> miles <u>W</u> of <u>Hollandale</u> (distance) (direction) (nearest town)			
WELL PURPOSE: <u>Irrigation</u> (home, irrigation, municipal, industrial)			
WELL COMPLETION DATA:			
(1) diameter (inches) <u>16</u>			
(2) total depth (feet) <u>110</u>			
(3) static water level (feet) <u>8</u> below above top of ground.			
(4) casing <u>Steel</u> , <u>70</u> (material) (depth) <u>16"</u> if telescope see back. (size)			
(5) screen <u>40'</u> , <u>70</u> (length) (depth to top)			
<u>16"</u> , <u>Mid Steel</u> (size) (material)			
(6) pump <u>60</u> , <u>3000</u> (HP) (yield gpm)			
<u>Diesel</u> (type power)			
(7) electric log <u>No</u> (yes or no)			
<u>120</u> (organization running log)			
(8) how well bottom plugged <u>None</u>			


CODED

1-14-85
 DW

DRILLERS REMARKS:

If well telescopes please sketch and show depths.

GROUND LEVEL

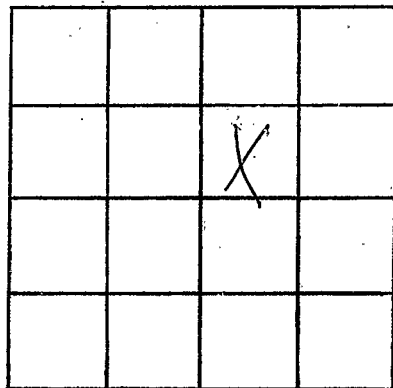

SECTION 29

Please indicate well location X.

ADDITIONAL INFORMATION

If more than one screen,
show locations of each on sketch.