

MISSISSIPPI DEPARTMENT OF NATURAL RESOURCES

Bureau of Land and Water Resources

Southport Mall

P.O. Box 10631

Jackson, Mississippi 39209

WATER WELL DRILLERS LOG

CODED

WASHINGTON  
K 74

1-30-1987  
date well completed

1987

Schultz Drilling WASHINGTON  
firm name county well located

LANDOWNER: LARRY Goss  
HWY 1 South  
Greenville, MS  
(mailing address)

description of formations encountered

from to

CLAY	0	20
SAND	20	60
SAND + pea gravel	60	100

CODED

WELL LOCATION:

sec 36 T 16 N R 8 E  
S S of James  
1/2 miles (distance) S (direction) of James (nearest town)

WELL PURPOSE: IRRIGATION  
(home, irrigation, municipal, industrial)

WELL COMPLETION DATA:

- (1) diameter (inches) 12"
- (2) total depth (feet) 100'
- (3) static water level (feet) 31' below top of ground.
- (4) casing PVC (material), 50' (depth)
- (size) If telescope see back.
- (5) screen 30' (length), 70' (depth to top)
- (size) (material)
- (6) pump 68 (HP), 800 (yield gpm)
- power unit (type power)
- (7) electric log No (yes or no)
- (organization running log)
- (8) how well bottom plugged CAP

RECEIVED


MAR 12 1987

Department of Natural Resources  
Bureau of Land & Water Resources

DRILLERS REMARKS:

If well telescopes please  
sketch and show depths.

GROUND LEVEL

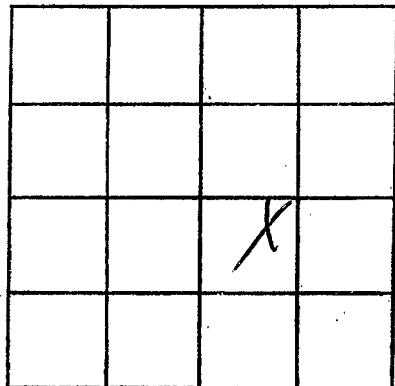

SECTION 36

Please indicate well location X.

ADDITIONAL INFORMATION

If more than one screen,  
show locations of each on sketch.