

MISSISSIPPI DEPARTMENT OF NATURAL RESOURCES

Bureau of Land and Water Resources

Southport Mall

P.O. Box 10631

Jackson, Mississippi 39209

WATER WELL DRILLERS LOG

Coded

TEP
W-009043
K 80

5-26 1988 date well completed

88 Dyer Well firm name

Washington county well located

LANDOWNER: Lake Land Farms

description of formations encountered

from

to

RT 1 Box 380
Hollandale Ms. 38748
(mailing address)

<u>Clay</u>	<u>0</u>	<u>35</u>
<u>Fine Sand</u>	<u>35</u>	<u>68</u>
<u>M. Sand & Gravel</u>	<u>68</u>	<u>75</u>
<u>Sand & Gravel</u>	<u>75</u>	<u>88</u>
<u>F Sand & Gravel</u>	<u>88</u>	<u>94</u>
<u>M Sand & Gravel</u>	<u>94</u>	<u>105</u>

WELL LOCATION:

sec 32 T 16 N R 8 E
12 miles W of Hollandale
(distance) (direction) (nearest town)

WELL PURPOSE: Irrigation
(home, irrigation, municipal, industrial)

WELL COMPLETION DATA:

- (1) diameter (inches) 16"
- (2) total depth (feet) 105'
- (3) static water level (feet) _____ below/above top of ground.
- (4) casing steel (material) _____ (depth) _____
16" (size) If telescope see back.
- (5) screen 40' (length) _____ (depth to top) _____
16" (size) _____ (material)
- (6) pump 60 (HP) _____ (yield gpm)
Gear (type power)
- (7) electric log No (yes, or no)
None (organization running log)
- (8) how well bottom plugged Plate

RECEIVED


JUN 06 1988

Department of Natural Resources
Bureau of Land & Water Resources

DRILLERS REMARKS:

If well telescopes please sketch and show depths.

GROUND LEVEL

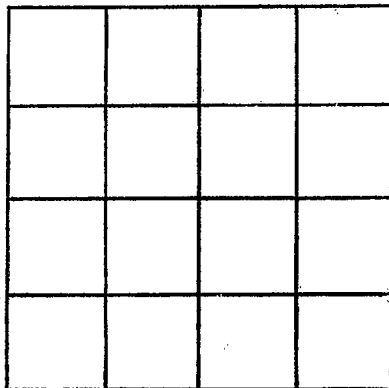

SECTION _____

Please indicate well location X.

ADDITIONAL INFORMATION

If more than one screen,
show locations of each on sketch.