

MISSISSIPPI DEPARTMENT OF NATURAL RESOURCES

Bureau of Land and Water Resources

Southport Mall

P.O. Box 10631

Jackson, Mississippi 39209

WATER WELL DRILLERS LOG

WASHINGTON
K 81

CODED

5-28 1988 Scholtz Drilling Washington
date well completed firm name county well located

W.C. Judge Skates Jr
LANDOWNER:

Description of formations encountered from to

P.O. Box 157

Crown Dr. 38753
(mailing address)

CLAY	0	38
Medium SAND	38	57
COARSE SAND	57	84


WELL LOCATION:

sec 12 T 16 N R 8 E
3 SE WAYSIDE
(distance) miles (direction) of (nearest town)

WELL PURPOSE:
(home, irrigation, municipal, industrial)

WELL COMPLETION DATA:

- (1) diameter (inches) 16"
- (2) total depth (feet) 84'
- (3) static water level (feet) 31' below above top of ground.
- (4) casing PVC 64' (material) (depth) (size) if telescope see back.
- (5) screen 20 64' (length) (depth to top) 16" PVC (size) (material)
- (6) pump 40 1000 (HP) (yield gpm) gear (type power)
- (7) electric log no (yes or no) (organization running log) CAP.
- (8) how well bottom plugged

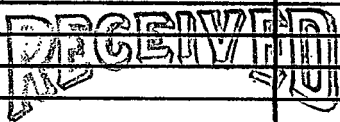


JUN 16 1988

Department of Natural Resources
Bureau of Land & Water Resources

DRILLERS REMARKS:

If well telescopes please sketch and show depths.

GROUND LEVEL

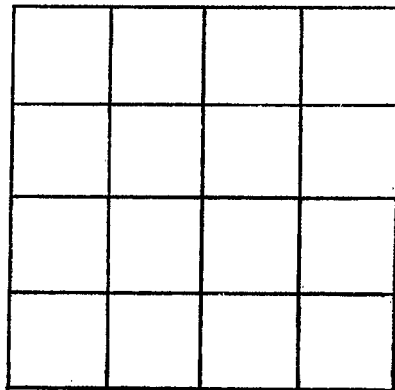

SECTION 12

Please indicate well location X.

ADDITIONAL INFORMATION

If more than one screen,
show locations of each on sketch.