

MISSISSIPPI DEPARTMENT OF NATURAL RESOURCES

Bureau of Land and Water Resources

COUNTY WELL LOCATED Washington	
WELL NUMBER K 83	CODED
DATE WELL COMPLETED April 14, 1988	

PERMIT NUMBER GW 8615
NAME OF DRILLING FIRM Larry's well & pump

CODED

P.O. Box 10631
Jackson, Mississippi 39209
WATER WELL DRILLERS LOG

NAME & MAILING ADDRESS OF LANDOWNER Wayne Davis		
WELL LOCATION: SEC TOWNSHIP RANGE SE 4 NW 1/4 23 16 N 8 E		
DISTANCE 2 Miles	DIRECTION South of	NEAREST TOWN AVON
OTHER LANDMARK		
WELL PURPOSE: Home <u>Irrigation</u> , Municipal, Industrial, Fish Pond, etc.		

PUMP DATA		
PUMP TYPE (Circle One): Submersible, <u>Turbine</u> Jet Flowing Well, Other (Describe) _____		
POWER TYPE (Circle One): Electric, Tractor, <u>Diesel</u> , Gasoline, Butane, Other (Describe) _____		
Pump Capacity (GPM) 1500	No. of Stages 1	Setting Depth 60 FT.
PUMP TEST		
Well yielded _____ GPM with a drawdown of _____ ft. after _____ hours of pumping		

WELL DATA		
Well Depth 130'	Casing Diameter (In.) 16"	Casing Length (Ft.) 90'
Type of Casing Steel	Hole Depth 130'	Depth to Static Water Level 20'
TYPE OF COMPLETION: (Circle One or More): <u>Gravel Packed</u> , Underreamed, Telescoped, Natural Development, Open Hole, Other (Describe) _____		
Top of Lap Pipe or Reduction in Casing FEET IF TELESCOPED OR MORE THAN ONE SCREEN: USE BACK PAGE		

LOG DATA	
TYPE OF LOG RUN (Circle One): Electric, Gamma Ray, Density, Sonic, Neutron, Other (Describe) _____	
Name of Organization Running Log _____	

SCREEN DATA		
Diameter - Inches 16"	Length - Feet 40'	Slot Size - Inches .060
Screen Type Steel	Depth to Bottom - Feet 130'	

GEOLOGIC DATA (Office Use Only)			
Surface Elev.	Geologic Unit	Unit Thickness	Depth to Top
Subs. SWL	Date	Analysis	Aquifer Test


Driller's Remarks

DESCRIPTION OF FORMATIONS ENCOUNTERED	FROM	TO	FORMATIONS (Continued) FROM TO
slay	0	95	RECEIVED OCT 25 1988 Department of Natural Resources Bureau of Land & Water Resources
sand & gravel	95	130	

IF MORE SPACE IS NEEDED, USE BACK

If well telescopes please sketch and show depths.

GROUND LEVEL

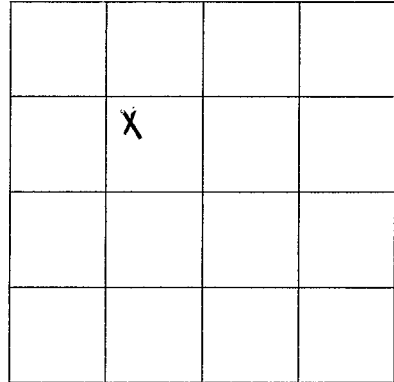

SECTION 23

Please indicate well location X.

ADDITIONAL INFORMATION

Lined area for additional information.

If more than one screen, show location of each on sketch.