

**MISSISSIPPI DEPARTMENT OF ENVIRONMENTAL QUALITY**  
Bureau of Land and Water Resources

P. O. Box 10631  
Jackson, MS 39289-0631  
**WATER WELL DRILLERS LOG**

COUNTY WELL LOCATED <i>Washington</i>	
WELL NUMBER <i>R 98</i>	CODED <input checked="" type="checkbox"/>
DATE WELL COMPLETED <i>2-10-93</i>	

PERMIT NUMBER
NAME OF DRILLING FIRM <i>Schudeo Ltd.</i>

NAME & MAILING ADDRESS OF LANDOWNER <i>Morris Lindsey</i>		
WELL LOCATION: SEC <u>1</u> TOWNSHIP <u>16</u> RANGE <u>8</u> <i>N S E W</i>		
DISTANCE <u>1</u> Miles	DIRECTION <u>S</u>	NEAREST TOWN <u>Wayside</u>
OTHER LANDMARK		
WELL PURPOSE <u>Home</u> Irrigation, Municipal, Industrial, Fish Pond, etc.		

PUMP DATA		
PUMP TYPE (Circle One): <u>Submersible</u> Turbine, Jet, Flowing Well, Other (Describe) _____		
POWER TYPE (Circle One): <u>Electric</u> Tractor, Diesel, Gasoline, Butane, Other (Describe) _____ H/P <u>1</u>		
Pump Capacity (GPM) <u>20</u>	No. of Stages <u>6</u>	Setting Depth <u>84</u> FT.
PUMP TEST		
Well yielded _____ GPM with a drawdown of _____ ft. after _____ hours of pumping		

WELL DATA		
Well Depth <u>340</u>	Casing Diameter (In.) <u>4X2</u>	Casing Length (Ft.) <u>320</u>
Type of Casing <u>pvc</u>	Hole Depth <u>340</u>	Depth to Static Water Level
TYPE OF COMPLETION: (Circle One or More): <u>Natural Development</u> Gravel Packed, Underreamed, Telescoped, Open Hole, Other (Describe) _____		
Top of Lap Pipe or Reduction in Casing  FEET IF TELESCOPED OR MORE THAN ONE SCREEN: USE BACK PAGE		

LOG DATA	
TYPE OF LOG RUN (Circle One): <u>No Log Run</u> Electric, Gamma Ray, Density, Sonic, Neutron, Other (Describe) _____	
Name of Organization Running Log	

SCREEN DATA		
Diameter - Inches <u>2 in</u>	Length - Feet <u>20</u>	Slot Size - Inches <u>.008</u>
Screen Type <u>pvc</u>	Depth to Bottom - Feet <u>340</u>	


GEOLOGIC DATA (Office Use Only)			
Surface Elev.	Geologic Unit	Unit Thickness	Depth to Top
Subs. SWL	Date	Analysis	Aquifer Test
Driller's Remarks			

DESCRIPTION OF FORMATIONS ENCOUNTERED	FROM	TO	FORMATIONS (Continued)	FROM	TO
<i>Top soil</i>	<i>0</i>	<i>3</i>	<b>RECEIVED</b>  <b>MAR 11 1993</b>		
<i>sand + gravel</i>	<i>3</i>	<i>118</i>			
<i>clay</i>	<i>118</i>	<i>200</i>			
<i>clay + sand streak</i>	<i>200</i>	<i>260</i>			
<i>shell + clay</i>	<i>260</i>	<i>310</i>			
<i>sand</i>	<i>310</i>	<i>340</i>			

IF MORE SPACE IS NEEDED, USE BACK

If well telescopes please sketch and show depths.

GROUND LEVEL

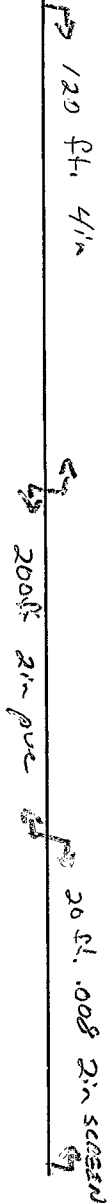

		X	

SECTION 1

Please indicate well location X.

ADDITIONAL INFORMATION

If more than one screen, show location of each on sketch.