

**MISSISSIPPI DEPARTMENT OF ENVIRONMENTAL QUALITY**

Office of Land and Water Resources

P. O. Box 10631  
Jackson, MS 39289-0631  
**WATER WELL DRILLERS LOG**

COUNTY WELL LOCATED  
Washington

WELL NUMBER 299 CODED

DATE WELL COMPLETED  
Sep 27-94

PERMIT NUMBER \_\_\_\_\_

NAME OF DRILLING FIRM  
Schudeco Ltd

NAME & MAILING ADDRESS OF LANDOWNER  
Orlando Wigley

Rt 2, Box 529

Hollandale Ms 38748

WELL LOCATION: SEC \_\_\_\_\_ TOWNSHIP 25 16 RANGE 8  N  S  E  W

DISTANCE 1 1/2 Miles DIRECTION S of NEAREST TOWN Greenville

OTHER LANDMARK \_\_\_\_\_

WELL PURPOSE:  Home Irrigation, Municipal, Industrial, Fish Pond, etc.

**PUMP DATA**

PUMP TYPE (Circle One):  
 Submersible Turbine, Jet, Flowing Well,  
Other (Describe) \_\_\_\_\_

POWER TYPE (Circle One):  
 Electric Tractor, Diesel, Gasoline, Butane,  
Other (Describe) \_\_\_\_\_ H/P 3

Pump Capacity (GPM) <u>50</u>	No. of Stages	Setting Depth <u>105</u> FT.
----------------------------------	---------------	---------------------------------

PUMP TEST

Well yielded \_\_\_\_\_ GPM with  
a drawdown of \_\_\_\_\_ ft.  
after \_\_\_\_\_ hours of pumping

**WELL DATA**

Well Depth <u>880</u>	Casing Diameter (In.) <u>4x3</u>	Casing Length (Ft.) <u>850</u>
Type of Casing <u>PVC</u>	Hole Depth <u>880</u>	Depth to Static Water Level

TYPE OF COMPLETION: (Circle One or More):  
 Gravel Packed,  Underreamed,  Telescoped,  
 Natural Development  Open Hole,  Other

WELL GROUTED TO A DEPTH OF 10 FEET  
Type Grout (circle one): Cement, Bentonite, or  Mix

**LOG DATA**

TYPE OF LOG RUN (Circle One):  No Log Run,  
Electric, Gamma Ray, Density, Sonic, Neutron,  
Other (Describe) \_\_\_\_\_

Name of Organization Running Log \_\_\_\_\_

**SCREEN DATA**

Diameter - Inches <u>3</u>	Length - Feet <u>30</u>	Slot Size - Inches <u>1008</u>
Screen Type <u>PVC</u>	Depth to Bottom - Feet <u>880</u>	

**GEOLOGIC DATA (Office Use Only)**

Surface Elev.	Geologic Unit	Unit Thickness	Depth to Top
Subs. SWL	Date	Analysis	Aquifer Test

Driller's Remarks \_\_\_\_\_

DESCRIPTION OF FORMATIONS ENCOUNTERED	FROM	TO	FORMATIONS (Continued)	FROM	TO
Top soil	0	4			
sand + gravel	4	138			
clay	138	240			
sand little shell	240	600			
shell	600	760			
sand	760	880			

**RECEIVED**


**JAN 11 1995**

Dept. of Environmental Quality  
Office of Land & Water Resources

IF MORE SPACE IS NEEDED, USE BACK

If well telescopes please sketch and show depths.

GROUND LEVEL

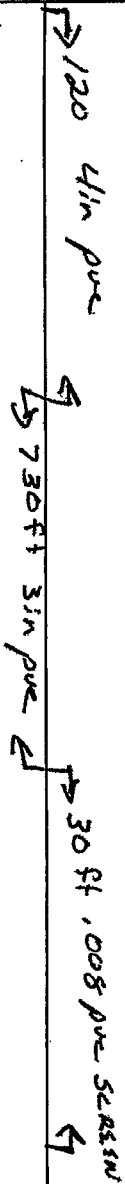

		X	

SECTION 25

Please indicate well location X.

ADDITIONAL INFORMATION

If more than one screen,  
show location of each on sketch.