

**MISSISSIPPI DEPARTMENT OF ENVIRONMENTAL QUALITY**

33-12-12 91-03-29

**QUALITY**

Office of Land and Water Resources

COUNTY WELL LOCATED <i>Washington</i>	
WELL NUMBER <i>K-111</i>	CODED
DATE WELL COMPLETED <i>6-21-01</i>	

PERMIT NUMBER
NAME OF DRILLING FIRM <i>Schudeo Ltd</i>

P. O. Box 10631  
Jackson, MS 39289-0631  
**WATER WELL DRILLERS LOG**

NAME & MAILING ADDRESS OF LANDOWNER <i>Keystone Plantation</i>			
<i>Avon, MS 38723</i>			
<i>(Anson Sheldon)</i>			
WELL LOCATION: SEC	TOWNSHIP	RANGE	
<i>6</i>	<i>16</i>	<i>8</i>	<i>N S E W</i>
DISTANCE	DIRECTION	NEAREST TOWN	
<i>1 1/2</i> Miles	<i>South</i>	<i>Avon</i>	
OTHER LANDMARK			
WELL PURPOSE: Home <u>Irrigation</u> Municipal, Industrial, Fish Pond, etc. <i>Replacement</i>			

<b>PUMP DATA</b>		
PUMP TYPE (Circle One): Submersible, Turbine, Jet, Flowing Well, Other (Describe) _____		
POWER TYPE (Circle One): Electric, Tractor, Diesel, Gasoline, Butane, Other (Describe) _____ H/P _____		
Pump Capacity (GPM)	No. of Stages	Setting Depth  FT.
PUMP TEST		
Well yielded _____ GPM with a drawdown of _____ ft. after _____ hours of pumping		

<b>WELL DATA</b>		
Well Depth <i>100</i>	Casing Diameter (In.) <i>16</i>	Casing Length (Ft.) <i>60</i>
Type of Casing <i>pvc</i>	Hole Depth <i>103</i>	Depth to Static Water Level

<b>LOG DATA</b>	
TYPE OF LOG RUN (Circle One): No Log Run, Electric, Gamma Ray, Density, Sonic, Neutron, Other (Describe) _____	
Name of Organization Running Log	

TYPE OF COMPLETION: (Circle One or More): <u>Gravel Packed</u> , Underreamed, Telescoped, Natural Development, Open Hole, Other			
WELL GROUTED TO A DEPTH OF _____ FEET Type Grout (circle one): Cement, Bentonite, or Mix			

<b>GEOLOGIC DATA (Office Use Only)</b>			
Surface Elev.	Geologic Unit	Unit Thickness	Depth to Top
Subs. SWL	Date	Analysis	Aquifer Test

<b>SCREEN DATA</b>		
Diameter - Inches <i>16</i>	Length - Feet <i>40</i>	Slot Size - Inches <i>1032</i>
Screen Type <i>pvc</i>	Depth to Bottom - Feet	


Driller's Remarks	
Top of Lap Pipe or Reduction in Casing  FEET <input type="checkbox"/> IF TELESCOPED OR MORE THAN ONE SCREEN; USE BACK PAGE	

DESCRIPTION OF FORMATIONS ENCOUNTERED	FROM	TO	FORMATIONS (Continued)	FROM	TO
<i>sandy top soil</i>	<i>0</i>	<i>7</i>			
<i>clay</i>	<i>7</i>	<i>16</i>			
<i>course sand + p-gravel</i>	<i>16</i>	<i>80</i>			
<i>course sand - p-gravel + gravel</i>	<i>80</i>	<i>103</i>			
<i>clay</i>	<i>103</i>				

**REC'D SEP 28 2001**

If well telescopes please  
sketch and show depths.

GROUND LEVEL

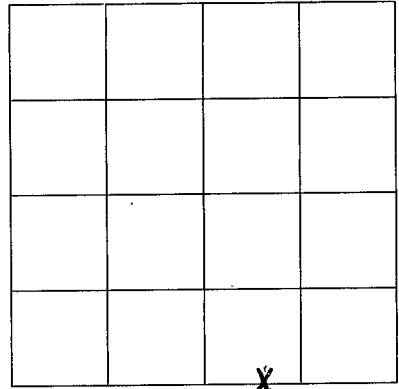

SECTION 6

Please indicate well location X.

ADDITIONAL INFORMATION

If more than one screen,  
show location of each on sketch.