
OPP Sum	Ridar	
State V	ell Report	For Office Use Only:
MACHENGET AL	Part 1	Aquifer: K 140
Permit # (210 4385) Office of Land	nt of Environmental Quality and Water Resources	Well #:
$\mathbf{P}$ .0.	Box 10631 MS 39289-0631	L. S. Elevation:
(60) (60)	)961-5210 54-6938 (fax)	E-log #:
State Law requires that this report be prepared by the		
30 days of completion of drilling of the well.		ell Location
Well Owner Information		
Owner Name Oppossum Ridge Farms		<u>S</u>
Mailing Address: Oppossum Ridge ferm	Method of Lat/Long (circle	
134 Curry Kd	USGS quad, Hand-he	d GPS, Survey-grade GPS
Hollandale MS 38748	SE 1/ SE 1/4 Sec 1/2	Twn 16N Rng 8W
City State Zip Code	Direction	of <u>AVON</u> MS.
Telephone No. ()	<u> </u>	
	ell Data	
Purpose of Well (circle one) Home Industrial Public Supp	ly Irrigation Fish Culture	Other:
Date well drilling started: $2 - 27 - 10$	ate well drilling completed:	2-27-10
If flowing, method of flow regulation: Valve Oth	er (describe)	
Static Water Level:feet above or below (circle of	ne) land surface Date measur	ed:
	tape air line other.	
Hole depth: <u>93</u> Well depth: <u>90</u>	Well grouted to a depth	of <u>10</u> feet
Type of grout (circle one): Cement Bentonite	Mix	
Casing length: feet Casing diameter:	inches Type of casin	g: PVC
Screen length: <u>40</u> feet Screen diameter: <u>16</u>		n: <u>Pvc</u>
Screen slot size: . 0.50 inches Setting depth: F	$\sim$	90 feet
Type of completion (circle all applicable): Gravel packed	Inderreamed Telescoped (	Open hole Natural Development
Other (describe):		
Top of lap pipe or reduction in casing:feel	. If telescoped or more than on	e screen, describe on back of page
Logs run (circle all applicable): No log run Electric Gamm		
Name of organization running log(s):		- He monthemate of the Mindowland
I certify that the well was drilled, constructed, and complet Department of Environmental Quality and/or the Mississip		
JOHN NEWLOME 0-773	40L	Newa-o
Print Name of Water Well Contractor and License No.	Signat	nure of Water Well Contractor
		REGEINE
		APR 0 7 2010
		84. OTME

If well telescopes please sketch below and show depths.



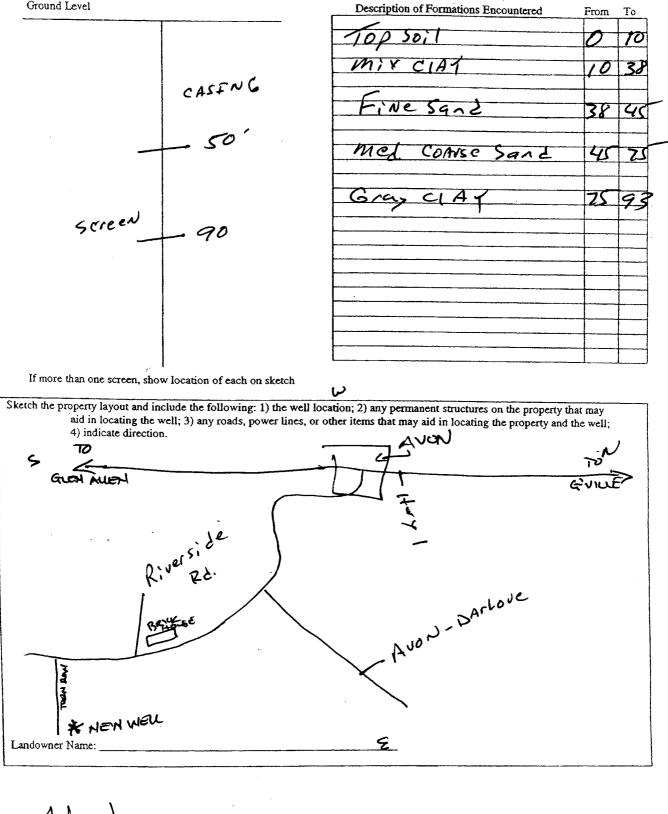

ature of Water Well Contractor

	STATE WELL REPORT	
County: Washington	Part 2 Pump Installer's Completion Report	For Office Use Only:
	ssissippi Department of Environmental Quality	Aquifer: $1/1/2$
Driller J, Wewcome	Office of Land and Water Resources P.O. Box 10631	<u> </u>
	Jackson, MS 39289-0631	Well #:
Date completed: <u>2-27-16</u>	(601)961-5210 (601)354-6938 (fax)	Elevation:
This report should be prepared by the pun installation of pump.	up installer in detail and filed with the Depart	ment within 30 days of the
Well Owner Information		Well Location
Owner Name: Opossum Ridge H	20005 Latitude: 33° 12' 15	Longinude: 91° 00' 13''
Mailing Address: Opposum Ridge	Harms Method of Lat/Long (circl	e one): Conventional Survey,
127 Wmy KC	USGS quad,	land-held GPS, Survey-grade GPS
Holandale, MS City State		22 Two IGN Rog &W
-	Distance Directio	n Nearest Town
Telephone No. ()	3 Miles SE	of Avan
Pump Type		Power Type
Circle one		Circle one
Air Lift Jet Sub	emersible Diesel Engine Gas	soline Engine Natural Gas
Bucket Piston	bine Electric Motor Ha	nd Tractor PTO
Centrifugal Rotary Flo	wing Well Windmill Otl	ber (specify):
Other (specify):	Horse Power Rating of Mo	
Date Pump Installed: 3/2/10	Setting Depth:	
Rated Pump Capacity: 1500 Gallo		
	ons Per Minute Number of Stages:	<u> </u>
Pump Test Data	Mathad at	Measuring Water Level
Date Well Tested:		Circle one
	Ala Tian The The State	Measuring Line Steel Tape
Static Water Level (A):Feet Below	W Land Surface	
Pumping Water Level (B):Feet Below		
Drawdown [(B) ~ (A)]:Feet Below	w Land Surface For flowing well, measure	d shut in head:feet
Test Pumping Rate:Gallo	and the second se	GPM with a drawdown of
Duration of Pump Test (minimum 4 hours):		
······································		erhours of pumping
I HEDEDV CEDTRAL		
I HEREBY CERTIFY that the above statements a	are true to the best of my knowledge	$\sim$
Cons Kowe G-7		Our
Print Name of Pump Installer and License No. (if	applicable) Signature on Pum	p-Installer
		APR 0 7 2