ſ	
	County: WASHINGTON
	Permit #: 6w44371
	Driller: J. HEWLOME 0773
	Date drilling completed: 6-16-10

Co-co *2 State Well Report

Part 1

Mississippi Department of Environmental Quality
Office of Land and Water Resources
P.O. Box 10631
Jackson, MS 39289-0631
(601)961-5210
(601)354-6938 (fax)

For Office Use Only:
Aquifer: 144
Aquiter:
Well #:
L. S. Elevation:
E-log #:

State Law requires that this report be prepared by the driller in detail and filed with the Department within 30 days of completion of drilling of the well.


30 days of completion of drilling of the well.					
Well Owner Information	Well Location				
Owner Name Coco Planting Co.	Latitude: 33.14,04" Longitude: 91.00,07"				
Mailing Address: 70 Box 143	Method of Lat/Long (circle one): Conventional Survey,				
	USGS quad, Hand-held GPS Survey-grade GPS /				
Na m4 38723	HH 14 HH14 Sec_ 18 V Twn 16 HV Rng BW				
Avon ms 38733 City State Zip Code					
	Distance Direction Nearest Town NE Miles 2.5 of Way State Non				
Telephone No. ()	Mines OI OI AVI				
Well	Data				
Purpose of Well (circle one) Home Industrial Public Supply	Irrigation Fish Culture Other:				
Date well drilling startes: -16 - 10 Date	well drilling completed: 10 10				
If flowing, method of flow regulation: Valve Other (c	describe)				
Static Water Level:feet above or below (circle one)	land surface Date measured:				
Method of Measurement (circle one) steel tape electric tape					
Hole depth: 90	_ Well grouted to a depth offeet				
Type of grout (circle one): Cement Bentonite Mix					
Casing length: 70 feet Casing diameter: 16 inches Type of casing: PVC					
Screen length: 20 feet Screen diameter: 16 inches Type of screen: PYC					
Screen slot size:	65.75 feet to 80 90 feet				
Type of completion (circle all applicable): Gravel packed Under	erreamed Telescoped Open hole Natural Development				
Other (describe):					
Top of lap pipe or reduction in casing:feet. If telescoped or more than one screen, describe on back of page					
Logs run (circle all applicable): No log run Electric Gamma Ray Density Sonic Neutron Other:					
Name of organization running log(s):					
I certify that the well was drilled, constructed, and completed in accordance with all applicable requirements of the Mississippi					
Department of Environmental Quality and/or the Mississippi Department of Health regulations and state laws.					
JOHN NEWCOME 0-773	4d newa				
Print Name of Water Well Contractor and License No.	Signature of Water Well Contractor				



Ground Level		
	CA52n6 -65	
SCIEET-	- 75 CASENG	
SCHEN	_90	

Description of Formations Encountered	From	To
TOP Soil	0	19
MYX CIAY	10	30
Fine Sand	30	65
COArse Sund	65	75
Fine sand	75	80
COBISC Sand	80	89
Gray CIAY	84	43

If more than one screen, show location of each on sketch

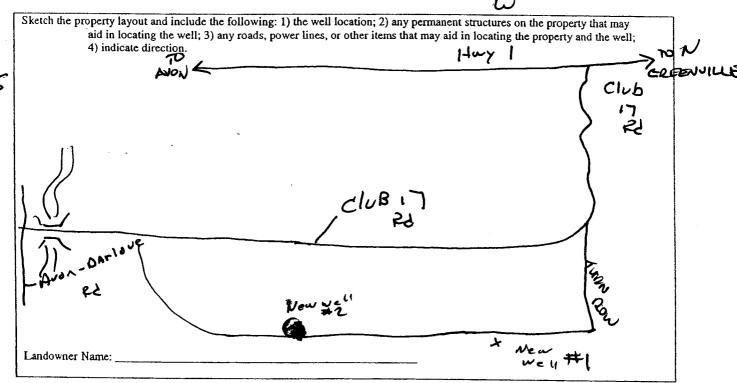

STATE WELL REPORT

Part 2

Pump Installer's Completion Report

Permit #: 60 443 |

Driller Newsone 0773 |

Pump Installer's Completion Report

Mississippi Department of Environmental Quality

Office of Land and Water Resources.

P.O. Box 10631

Jackson, MS 39289-0631

Completed: 10-10 (601)961-5210

For Office Use Only:			
Aquifer: K144			
Well#:			
Elevation:			

This report should be prepared by the pump installer in detail and filed with the Department within 30 days of the installation of pump. Well Owner Information Owner Name: See Planting (a. Method of Lat/Long (circle one): Conventional Survey. Milling Address: Porso 143 Method of Lat/Long (circle one): Conventional Survey. Well Location Well Location Well Location Well Location Well Location Method of Lat/Long (circle one): Conventional Survey. Wisk of Gland-head IBP. Survey grade GPS Note: Since Two Direction Nearest Town Distance Direction Nearest Town Pump Type Circle one Circle one Air Lift Jet Submersible Bucket Piston Turbine Centrifugal Rotary Flowing Well Windmill Other (specify): Horse Power Rating of Motor: Centrifugal Rotary Flowing Well Windmill Other (specify): Horse Power Rating of Motor: Setting Depth: Number of Stages: Pump Test Data Method of Measuring Water Level Circle one Air Line Electric Measuring Line Steel Tape Other (specify): Other (specify): Feet Below Land Surface Pumping Water Level (B): Feet Below Land Surface Prawdown [(B) - (A)]: Feet Below Land Surface For flowing well, measured shut in head: GPM with a drawdown of Duration of Pump Test (minimum 4 hours): bours I HEEREBY CERTIFY that the above statements are true to the best of my knowledge-		(601)354-6938 (fax) Elevar	tion:
Well Location Owner Name: Cos Planting Co Mailing Address: PD 183x 143 Method of LatilLong (circle one): Conventional Survey,	This report should be prepared by the pump installe installation of pause.	in detail and filed with the Department within	a 30 days of the
Method of Lat/Long (circle one): Conventional Survey, USGS quad. Hand-held GPR. Survey-grade GPS NW 14 NW 14 See 18 Twn 16W Rng WU Distance Direction Nearest Town 2.5 Miles NW of Autor Pump Type Circle one Air Lift Jet Submersible Bucket Piston Turbine Centrifugal Rotary Flowing Well Other (specify): Horse Power Rating of Motor: Date Pump Installed: Date Pump Capacity: OCO Gallons Per Minute Pump Test Data Method of Lat/Long (circle one): Conventional Survey, USGS quad. Hand-held GPR. Survey-grade GPS NW 14 NW 14 See 18 Twn 16W Rng WU Distance Direction Nearest Town Circle one Circle one Circle one Diesel Engine Gasoline Engine Natural Gas Electric Motor Hand Tractor PTO Windmill Other (specify): Horse Power Rating of Motor: OCO Setting Depth: Number of Stages: Pump Test Data Method of Measuring Water Level Circle one Air Line Electric Measuring Line. Steel Tape Other (specify): Pother (specify): Feet Below Land Surface Pumping Water Level (B): Feet Below Land Surface Prawdown (B) – (A)]: Feet Below Land Surface For flowing well, measured shut in head: GPM with a drawdown of Well yielded GPM with a drawdown of feet after hours of pumping		Well Locati	00
Method of Lat/Long (circle one): Conventional Survey, USGS quad. Hand-held GPR. Survey-grade GPS NW 14 NW 14 See 18 Twn 16W Rng WU Distance Direction Nearest Town 2.5 Miles NW of Autor Pump Type Circle one Air Lift Jet Submersible Bucket Piston Turbine Centrifugal Rotary Flowing Well Other (specify): Horse Power Rating of Motor: Date Pump Installed: Date Pump Capacity: OCO Gallons Per Minute Pump Test Data Method of Lat/Long (circle one): Conventional Survey, USGS quad. Hand-held GPR. Survey-grade GPS NW 14 NW 14 See 18 Twn 16W Rng WU Distance Direction Nearest Town Circle one Circle one Circle one Diesel Engine Gasoline Engine Natural Gas Electric Motor Hand Tractor PTO Windmill Other (specify): Horse Power Rating of Motor: OCO Setting Depth: Number of Stages: Pump Test Data Method of Measuring Water Level Circle one Air Line Electric Measuring Line. Steel Tape Other (specify): Pother (specify): Feet Below Land Surface Pumping Water Level (B): Feet Below Land Surface Prawdown (B) – (A)]: Feet Below Land Surface For flowing well, measured shut in head: GPM with a drawdown of Well yielded GPM with a drawdown of feet after hours of pumping	Owner Name: Low Planting Co.	Latitude: 33 14 64 Longit	mde: 91 00 07
City State Zip Code Distance Direction Nearest Town Distance Direction Nearest Town Distance Direction Nearest Town Distance Direction Nearest Town Distance Direction Nearest Town Distance Direction Nearest Town Distance Direction Nearest Town Distance Direction Nearest Town Distance Direction Nearest Town Distance Direction Nearest Town Distance Direction Nearest Town Distance Direction Nearest Town Distance Direction Nearest Town Distance Direction Nearest Town Distance Direction Nearest Town Distance Distance Distance Distance Direction Nearest Town Distance Distance	Mailing Address: PO Box 143		i i
City State Zip Code Distance Direction Nearest Town Distance Direction Nearest Town Distance Direction Nearest Town Distance Direction Nearest Town Distance Direction Nearest Town Distance Direction Nearest Town Distance Direction Nearest Town Distance Direction Nearest Town Distance Direction Nearest Town Distance Direction Nearest Town Distance Direction Nearest Town Distance Direction Nearest Town Distance Direction Nearest Town Distance Direction Nearest Town Distance Direction Nearest Town Distance Distance Distance Distance Direction Nearest Town Distance Distance		USGS quad, Hand-held G	PS, Survey-grade GPS
Distance Direction Nearest Town	Avon, ms 38723	NW 14 NW 14 Sec 18 To	
Pump Type Circle one Air Lift Bucket Piston Turbine Centrifugal Rotary Flowing Well Windmill Other (specify): Horse Power Rating of Motor: Setting Depth: Torcle one Natural Gas Windmill Other (specify): Horse Power Rating of Motor: Setting Depth: Pump Test Data Pump Test Data Pump Test Data Method of Measuring Water Level Circle one Number of Stages: Number of Stages: Other (specify): Pump Test Data Method of Measuring Water Level Circle one Air Line Electric Motor Hand Tractor PTO Setting Depth: Column Depth: Feet Below Land Surface Pumping Water Level (A): Feet Below Land Surface Pumping Water Level (B): Feet Below Land Surface Por flowing well, measured shut in head: For flowing well, measured shut in head: Method of Measuring Line Steel Tape Other (specify): For flowing well, measured shut in head: Method of Measuring Line Steel Tape Other (specify): For flowing well, measured shut in head: Method of Measuring Line Steel Tape Other (specify): For flowing well, measured shut in head: Method of Measuring Line Steel Tape Other (specify): For flowing well, measured shut in head: Method of Measuring Line Steel Tape Other (specify): For flowing well, measured shut in head: Method of Measuring Line Steel Tape Other (specify): For flowing well, measured shut in head: Method of Measuring Line Steel Tape Other (specify): For flowing well, measured shut in head: Method of Measuring Line Steel Tape Other (specify): For flowing well, measured shut in head: Method of Measuring Line Steel Tape Other (specify): For flowing well, measured shut in head: Method of Measuring Line Steel Tape Other (specify): For flowing well, measured shut in head: Method of Measuring Line Steel Tape Other (specify): For flowing well, measured shut in head: Method of Measuring Line Steel Tape Other (specify): Method of Measuring Line Steel Tape Other (specify): Method of Measuring Line Steel Tape Other (specify): Method of Measuring Line Steel Tape	City State Zip Cod	1	arest Town
Air Lift Jet Submersible Bucket Piston Turbine Centrifugal Rotary Flowing Well Windmill Other (specify): Horse Power Rating of Motor: Setting Depth: Rated Pump Capacity: Pump Test Data Pump Test Data Method of Measuring Water Level Circle one Number of Stages: Air Line Feet Below Land Surface Drawdown [(B) – (A)]: Feet Below Land Surface For flowing well, measured shut in head: Test Pumping Rate: Gallons Per Minute Circle one Air Line Flect Below Land Surface For flowing well, measured shut in head: Feet Below Land Surface For flowing well, measured shut in head: Feet Measuring Circle one Air Line Feet Below Land Surface For flowing well, measured shut in head: Feet Measuring Circle one Air Line Feet Below Land Surface For flowing well, measured shut in head: Feet Measuring Circle one Air Line Feet Below Land Surface Other (specify): Well yielded Feet after hours of pumping	Telephone No. ()	The state of the s	
Air Lift Jet Submersible Bucket Piston Turbine Centrifugal Rotary Flowing Well Windmill Other (specify): Horse Power Rating of Motor: Setting Depth: Rated Pump Capacity: Pump Test Data Pump Test Data Pumping Water Level (A): Feet Below Land Surface Drawdown [(B) - (A)]: Feet Below Land Surface Test Pumping Rate: Gallons Per Minute Circle one Circle one Natural Gas Belectric Motor Hand Tractor PTO Setting Depth: Number of Stages: Method of Measuring Water Level Circle one Air Line Electric Motor Hand Tractor PTO Setting Depth: Corcle one Air Line Feet Below Land Surface Other (specify): Pother (specify): Well yielded GFM with a drawdown of Duration of Pump Test (minimum 4 hours): bours feet after hours of pumping	Down Trees		
Bucket Piston Turbine Electric Motor Hand Tractor PTO Centrifugal Rotary Flowing Well Windmill Other (specify):	Circle one		
Centrifugal Rotary Flowing Well Windmill Other (specify):	Air Lift Jet Submersible	Diesel Engine Gasoline Engin	ne Natural Gas
Other (specify): Date Pump Installed: Pump Test Data Pump Test Data Pump Test Below Land Surface Pumping Water Level (A): Peet Below Land Surface Drawdown [(B) – (A)]: Feet Below Land Surface Test Pumping Rate: Gallons Per Minute Horse Power Rating of Motor: Setting Depth: Number of Stages: Method of Measuring Water Level Circle one Air Line Electric Measuring Line Other (specify): Pother (specify): Feet Below Land Surface For flowing well, measured shut in head: Feet Minute Well yielded GFM with a drawdown of Duration of Pump Test (minimum 4 hours): hours hours Feet after hours of pumping	Bucket Piston Turbine	Electric Motor Hand	Tractor PTO
Date Pump Installed:	Centrifugal Rotary Flowing Well	Windmill Other (specify):
Pump Test Data Pump Test Data Pump Test Below Land Surface Pumping Water Level (B): Feet Below Land Surface Drawdown [(B) - (A)]: Feet Below Land Surface Drawdown Feet Below Land Surface Drawdown Feet Below Land Surface Drawdown [CB] - (A)]: Feet Below Land Surface Drawdown Feet Below Land Surface For flowing well, measured shut in head: feet Well yielded GPM with a drawdown of Duration of Pump Test (minimum 4 hours): hours feet after hours of pumping	Other (specify):	Horse Power Rating of Motor:	00
Pump Test Data Pump Test Data Method of Measuring Water Level Circle one Air Line Electric Measuring Line Steel Tape Other (specify): Drawdown [(B) – (A)]: Feet Below Land Surface Drawdown [(B) – (A)]: Feet Below Land Surface For flowing well, measured shut in head: Feet Below Land Surface For flowing well, measured shut in head: Well yielded GPM with a drawdown of Duration of Pump Test (minimum 4 hours): hours hours feet after hours of pumping	Date Pump Installed:	Setting Depth: 70	
Date Well Tested: Static Water Level (A): Pumping Water Level (B): Feet Below Land Surface Drawdown [(B) - (A)]: Feet Below Land Surface For flowing well, measured shut in head: Feet Pumping Rate: Gallons Per Minute Well yielded GPM with a drawdown of Duration of Pump Test (minimum 4 hours): hours Circle one Air Line Flectric Measuring Line Steel Tape Other (specify): Well yielded GPM with a drawdown of feet after hours of pumping	Rated Pump Capacity: OOO Gallons Per M		
Date Well Tested: Static Water Level (A): Feet Below Land Surface Pumping Water Level (B): Feet Below Land Surface Drawdown [(B) - (A)]: Feet Below Land Surface Test Pumping Rate: Gallons Per Minute Duration of Pump Test (minimum 4 hours): hours Air Line	Pump Test Data	Method of Measuring	Water Level
Static Water Level (A):Feet Below Land Surface Pumping Water Level (B):Feet Below Land Surface Drawdown [(B) - (A)]:Feet Below Land Surface Test Pumping Rate:Gallons Per Minute Duration of Pump Test (minimum 4 hours):hours Air Line	Date Well Tested:	. Circle on	
Pumping Water Level (B): Feet Below Land Surface Drawdown [(B) - (A)]: Feet Below Land Surface For flowing well, measured shut in head: feet Well yielded GPM with a drawdown of hours of pumping Duration of Pump Test (minimum 4 hours): hours		Air Line Electric Measuring	Line Steel Tape
Test Pumping Rate:Gallons Per Minute	•	Other (specify):	
Duration of Pump Test (minimum 4 hours): hours feet after hours of pumping	Drawdown [(B) - (A)]: Feet Below Land St	rface For flowing well, measured shut in he	ead:feet
Duration of Pump Test (minimum 4 hours):hours	Test Pumping Rate:Gallons Per M	inute Well yielded GPM	I with a drawdown of
I HEREBY CERTIFY that the above statements are true to the best of my knowledge	Duration of Pump Test (minimum 4 hours):		
I HEREBY CERTIFY that the above statements are true to the best of my knowledge			Ar .
	I HEREBY CERTIFY that the above statements are true to	the best of my knowledge	·
Con Koure 0-711P (Good	Con Koure 0-7	IIP (hoor	u
Print Name of Pump Installer and License No. (if applicable) Signature of Pump Installer	Frunt Name of Pund Installer and License No. (if applicab	e) Signature of Pump Installer	A CE

400 05 2010