
State Well	Report		
	-	For Office Use Only:	
Part 1 Mississippi Department of Environmental Quality		Aquifer: <u>K 145</u>	
Office of Land and Water Resources		Well #:	
Jackson, MS 39	9289-0631	L. S. Elevation:	
		E-log #:	
g of the well.			
AUOU		Vell Location	
ing Co. La	titude: 33 • 15 • 02	_" Longitude. <u>" ° 00 ' \$ ["</u>	
143 Me			
36723 N	E 4 NE 4 Sec_ 14	Twnlon Rngoln	
Di	istance Direction 3.1 Miles EASH	of AUDI INS	
Well Data	a		
ndustrial Public Supply	rigation Fish Culture	Other:	
Date well	drilling completed:	-2-10	
•			
Bentonite Mix			
asing diameter: <u>16</u> i	inches Type of casing:	PVC	
	inches Type of screen:	PVL	
s Setting depth: From	SO feet to 9	<u>o</u> feet	
run Electric Gamma Ray 1	Density Sonic Neutron		
-		Other:	
	andonaa midh all an-li-ah		
istructed, and completed in acc ty and/or the Mississippi Depar		le requirements of the Mississippi	
nstructed, and completed in acc	tment of Health regulatio	le requirements of the Mississippi ns and state laws.	
nstructed, and completed in acc	tment of Health regulatio	le requirements of the Mississippi ns and state laws.	
nstructed, and completed in acc ty and/or the Mississippi Depar	tment of Health regulatio	le requirements of the Mississippi ns and state laws.	
nstructed, and completed in acc ty and/or the Mississippi Depar	rtment of Health regulation	le requirements of the Mississippi ns and state laws. Deuce of Water Well Contractor WED RECEW	
nstructed, and completed in acc ty and/or the Mississippi Depar	tment of Health regulatio	le requirements of the Mississippi ns and state laws. Deuce of Water Well Contractor WED RECEW AUG 1 t 20 0 0 0 0 0 0 0 0 0 0 0 0 0 0 0 0 0 0	
	P.O. Box 1 Jackson, MS 39 (601)961- (601)354-69 port be prepared by the drill g of the well. mation in a C La 143 La 143 La 143 M 38733 La 143 M 38733 La 143 M 38733 La 143 M 38733 La 143 M 38733 La 143 M M 38733 La 143 M M M M M M M M M M M M M M M M M M M	P.O. Box 10631 Jackson, MS 39289-0631 (601)961-5210 (601)354-6938 (fax) well ination well ina Method of Lat/Long (circle or USGS quad, Hand-held NE 14 NE 14 Sec	

If well telescopes please sketch below and show depths.

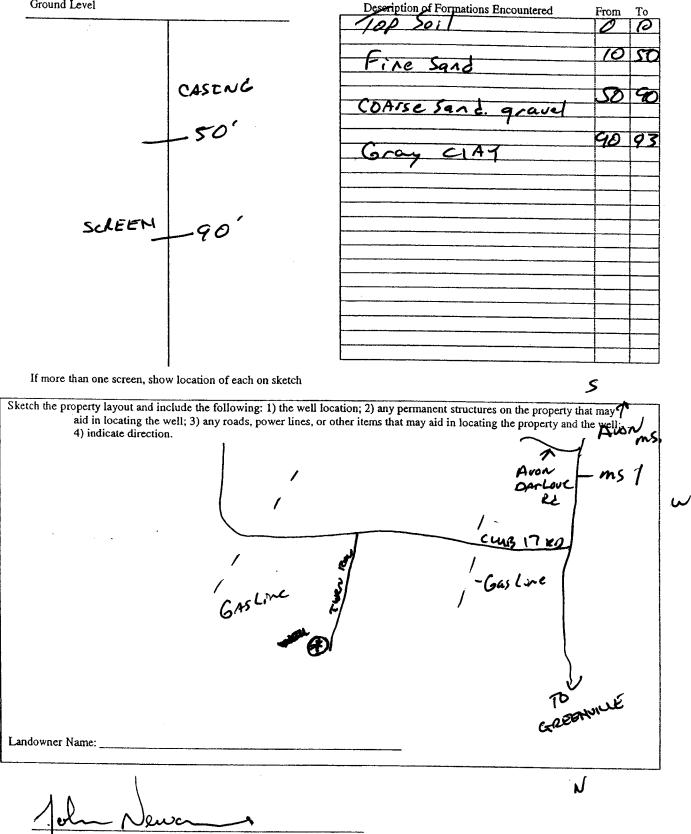

£



Signature of Water Well Contractor

	STATE WI	ELL REPORT	
County: Washington Permit #: 669 438555 Driller. J. Newcome 0-773 Date completed: 7-3-10	Part 2 Pump Installer's Completion Report Mississippi Department of Environmental Quality Office of Land and Water Resources. P.O. Box 10631 Jackson, MS 39289-0631 (601)961-5210 (601)354-6938 (fax)		For Office Use Only: Aquifer: /٤/45 Well #:
This report should be prepared by the installation of pump.		il and filed with the Departme	nt within 30 days of the
Well Owner Information			Il Location
Mailing Address: PD Box 14	\ \	Method of Lat/Long (circle or	Longitude: <u>910037</u> ne): Conventional Survey,
Avon, ms City State		NE 1/4 NE 1/4 Sec_T Distance Direction	d-held GPS, Survey-grade GPS Twn CN Rng SW Nearest Town of Avon MS
Pump Type Circle one			wer Type ircle one
Air Lift Jet	Submersible		ne Engine Natural Gas
Bucket Piston	Turbine	Electric Motor Hand	Tractor PTO
Centrifugal Rotary	Flowing Well	Windmill Other	(specify):
Other (specify): Date Pump Installed: Rated Pump Capacity:	Gallons Per Minute	Horse Power Rating of Motor Setting Depth: (Number of Stages:)	2
Pump Test Data	· · · · · · · · · · · · · · · · · · ·		easuring Water Level Circle one
Date Well Tested:Feet Static Water Level (A):Feet	Below Land Surface	Air Line Electric Mer Other (specify):	asuring Line Steel Tape
Pumping Water Level (B):Feet			
Drawdown [(B) – (A)]: Feet			
Test Pumping Rate: Duration of Pump Test (minimum 4 hours):		Well yieldedfeet after _	GPM with a drawdown ofhours of pumping
I HEREBY CERTIFY that the above statem COMPARE ROWC Print Name of Panp Installer and License N	2-711P	Signature of Pump I RECE	2010 INR BY: OLWF