

County: Washington  
 Permit #: GW 47346  
 Driller: Charles M. Nichols  
 Date drilling completed: 6-27-13

# STATE WELL REPORT

## Part 1

### Driller's Log

Mississippi Department of Environmental Quality  
 Office of Land and Water Resources  
 P.O. Box 2309  
 Jackson, MS 39225-2309  
 (601) 961-5210  
 (601) 360-0535 (fax)

**For Office Use Only:**  
 Well #: K168  
 Aquifer: \_\_\_\_\_  
 E-Log #: \_\_\_\_\_

*State Law requires that this report be prepared by the license holder responsible for the work and filed with the Department at the above address within 30 days of completion of drilling of the well or borehole.*

Well Owner Information (Landowner if borehole is not for a water well)	Well or Borehole Location
Owner Name: <u>Greenlee Farms</u>	Latitude: <u>33°17'56"N</u> Longitude: <u>91°4'56"W</u>
Mailing Address: <u>359 Crittenden</u>	<u>33-12-14</u> <u>91-03-56</u> Method of Lat/Long (check one): <input type="checkbox"/> Conventional Survey,
<u>Greenville MS. 38701</u> City State Zip code	<input type="checkbox"/> USGS quad, <input checked="" type="checkbox"/> Hand-held GPS, <input type="checkbox"/> Survey-grade GPS
Telephone No. ( ) -	<u>1R 1/4 NW 1/4, Sec 25 T 16N R 8W</u>
	<u>5 1/4</u> Miles <u>SW</u> of <u>Wayside</u> (Distance) (Direction) (Nearest Town)

**Well / Borehole Data**

Date drilling started: 6-27-13 Date drilling completed: 6-27-13 Hole depth: 100 Hole diameter: 16

Location of the source of any surface water used for drilling: Farm well

Method of dosing and volume of Chlorine used in drilling and development: HTH

Logs run (check all applicable):  No log run  Electric  Gamma Ray  Density  Sonic  Neutron  Other: \_\_\_\_\_

Name of organization running log(s): \_\_\_\_\_

Purpose of borehole (check one):  Water Well  Geotechnical/Geological Investigation  Ground Source Heat Pump  
 Seismic Survey  Other (describe) \_\_\_\_\_

*If drilling is not related to water well construction, skip the remainder of this block*

Purpose of Well (check all applicable):  Home  Industrial  Public Supply  Irrigation  Fish Culture  
 Other (describe): \_\_\_\_\_

If a flowing well, method of flow regulation: Valve \_\_\_\_\_ Other (describe) \_\_\_\_\_

Static Water Level: 14 feet [ above or  below] land surface Date measured: 7-2-13  
 (check one)

Method of Measurement (check one)  Steel tape  Electric tape  Air line  Other: (describe) \_\_\_\_\_

Well depth: 100 Well grouted to a depth of: 10 feet Type of grout (check one):  Neat Cement  Bentonite  Mix

Casing length: 80 feet Casing diameter: 16 inches Type of casing: pvc

Screen length: 20 feet Screen diameter: 16 inches Type of screen: pvc

Screen slot size: .032 inches Setting depth: From 80 feet to 100 feet

Type of completion (check all applicable):  Gravel packed  Underreamed  Open hole  Natural Development  
 Other (describe): \_\_\_\_\_

Top of lap pipe or reduction in casing: \_\_\_\_\_ Feet


*If telescoped or more than one screen, describe on next page*

Form: OLWR-SWR-1A (4/13)

County: Washington  
 Permit #: GW 47346

**For Office Use Only:**  
 Well #: K16E

*The sketch below only required for water wells*  
*If well telescopes, show depths on sketch.*

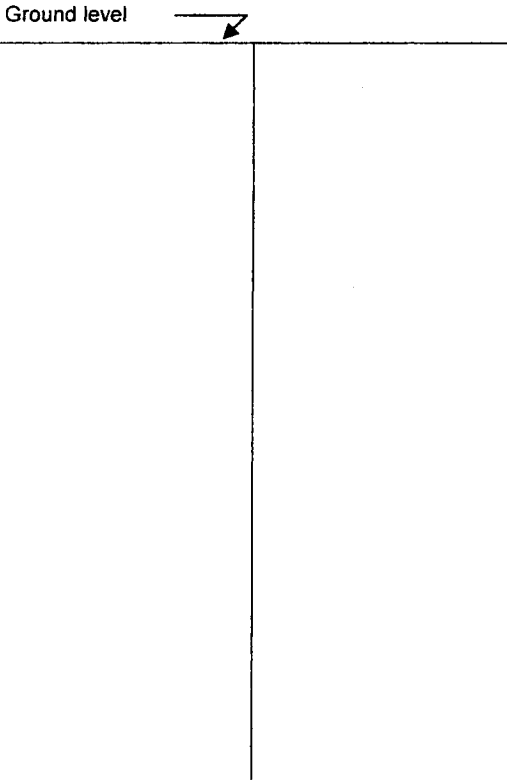

**Description of formations encountered must be provided for all wells and boreholes, unless specifically exempted by regulations**

Description of Formations Encountered	From (depth)	To (depth)
	Ground level	
Clay	0	8
Fine sand + clay	8	50
Clay	50	80
Coarse sand + p-gravel	80	100
Cemented gravel	100	

If more than one screen, show location of each on sketch

Sketch the property layout and include the following:

- 1) the well location
- 2) any permanent structures on the property that may aid in locating the well
- 3) any roads, power lines, or other items that may aid in locating the property and the well
- 4) a north arrow

Landowner Name: Greenlee Farms

Form: OLWR-SWR-1A (04/08)

I HEREBY CERTIFY that the well/borehole was drilled, constructed, and completed in accordance with all applicable requirements of the Mississippi Department of Environmental Quality and the Mississippi Department of Health regulations, if applicable, and state laws.

Charles M. Nichols 667  
 Print Name of Responsible Licensee and License No.

4-3-13  
 Date

Charles M. Nichols  
 Signature of Licensee

Form: OLWR-SWR-1A (4/13)

County: Washington  
 Permit #: GW 47346  
 Driller: Charles M. Nichols  
 Date drilling completed: \_\_\_\_\_  
Copy information from block on Part 1

### STATE WELL REPORT

#### Part 2

**Pump Installer's Completion Report**  
 Mississippi Department of Environmental Quality  
 Office of Land and Water Resources  
 P.O. Box 2309  
 Jackson, MS 39225-2309  
 (601) 961-5210  
 (601) 360-0535 (fax)

**For Office Use Only:**  
 Well #: K168  
 Aquifer: \_\_\_\_\_

*This part of the report must be completed by a licensed water well contractor or a licensed pump installer. A copy of Part 1 of the report must be attached and both parts filed with the Department at the above address within 30 days of well completion.*

Well Owner Information	Well Location
Owner Name: <u>Greenlee Farms</u>	Latitude: <u>30°17'56"N</u> Longitude: <u>91°4'56"W</u>
Mailing Address: <u>359 Crittenden</u>	Method of Lat/Long (check one): <input type="checkbox"/> Conventional Survey, <input type="checkbox"/> USGS quad, <input type="checkbox"/> Hand-held GPS, <input type="checkbox"/> Survey-grade GPS
<u>Greenville MS 38701</u>	<u>1/4 NW 1/4, Sec 25 T16N R 8W</u>
City State Zip code	<u>5 1/4</u> Miles <u>SW</u> of <u>Wayside</u>
Telephone No. ( ) -	(Distance) (Direction) (Nearest Town)

**Pump Type (check one)**

Submersible  Turbine  Air Lift  Centrifugal  Flowing Well  Jet  Piston  Rotary  Other (describe): \_\_\_\_\_

Date Pump Installed 7-2-13 Rated Pump Capacity: 600 Gallons Per Minute

Is This Pump (check one):  New  Repaired  Replacement

**Power Type (check one)**

Electric  Diesel  Gasoline  Natural Gas  Tractor PTO  Windmill  Other (describe): \_\_\_\_\_

Horse Power Rating of Motor: 10 Setting Depth: 60 feet Number of Stages: 1

**Pump Test Data for Non Flowing Well**

Date Well Tested: \_\_\_\_\_ Duration of Pump Test (minimum 4 hours): \_\_\_\_\_ hours

Static Water Level (A): 14 Feet Below Land Surface Pumping Water Level (B): \_\_\_\_\_ Feet Below Land Surface

Drawdown [(B) - (A)]: \_\_\_\_\_ Feet Below Land Surface Test Pumping Rate: \_\_\_\_\_ Gallons Per Minute

Method of measurement (check one):  Steel tape  Electric tape  Air line  Other (describe): \_\_\_\_\_

**Pump Test Data for Flowing Well**

Measured shut in head: \_\_\_\_\_ feet

Well yielded \_\_\_\_\_ GPM with a drawdown of \_\_\_\_\_ feet after \_\_\_\_\_ hours of pumping

**Meter Installation**

Meter Manufacturer: J.M. Geysler Meter Serial Number: 0670690

Meter Model Number/Name: 6" Type of Meter: propeller

Totalizer Register Unit and Multiplier Factor (AF x .001, gal x 1000, etc): \_\_\_\_\_

Installation Date: 7-2-13 Meter installed by: Charles M. Nichols

Is This Meter (check one):  New  Repaired  Replacement

*Important: By submitting the above information you are certifying that this meter was installed to manufacturer standards. For agricultural wells, a list of approved meters is on the MDEQ website.*

I HEREBY CERTIFY that the above statements are true to the best of my knowledge.

Charles M. Nichols 667 4-3-14 Charles M. Nichols  
 Print Name of Pump Installer and License No. (if applicable) Date Signature of Pump Installer