

WASHINGTON  
K 1001  
4-5-71

MISSISSIPPI  
BOARD OF WATER COMMISSIONERS  
416 North State Street  
Jackson, Mississippi 39201

**CODED**

WATER WELL DRILLERS LOG  
DYER WELL & IRRIGATION SERVICE

WASHINGTON

4/5/71 19  
date well completed

firm name

county well located

LANDOWNER:  
C. D. HOBART  
ADON, MISS  
(mailing address)

description of formations encountered	from	to
CLAY	0	20
FINE SAND	20	46
SAND + GRAVEL	46	50
CLAY	50	63
SAND + GRAVEL	63	75
CLAY	75	90

WELL LOCATION:  
sec. 20 T 16 N R 8 E  
3 miles S.E. of Adon  
(distance) (direction) (nearest town)

WELL PURPOSE: IRR.  
(home, irrigation, municipal, industrial)

- WELL COMPLETION DATA:
- (1) diameter (inches) \_\_\_\_\_
  - (2) total depth (feet) \_\_\_\_\_
  - (3) static water level (feet) \_\_\_\_\_ below above top of ground.
  - (4) casing \_\_\_\_\_ (material) \_\_\_\_\_ (depth) \_\_\_\_\_  
\_\_\_\_\_ (size) if telescope see back.
  - (5) screen \_\_\_\_\_ (length) \_\_\_\_\_ (depth to top) \_\_\_\_\_  
\_\_\_\_\_ (size) \_\_\_\_\_ (material)
  - (6) pump \_\_\_\_\_ (HP) \_\_\_\_\_ (yield gpm) \_\_\_\_\_  
\_\_\_\_\_ (type power)
  - (7) electric log \_\_\_\_\_ (yes or no) \_\_\_\_\_  
\_\_\_\_\_ (organization running log)
  - (8) how well bottom plugged \_\_\_\_\_

**CODED**


MAY 3 - 1971

MISS. BD. OF  
WATER COMMISSIONERS

DRILLERS REMARKS: Did Not  
Case Well Since  
Formation Was Not  
Suitable For  
Volume Desired

If well telescopes please sketch and show depths.

GROUND LEVEL

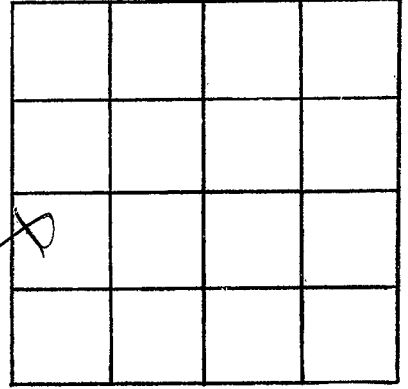

SECTION 20

Please indicate well location X.

ADDITIONAL INFORMATION

If more than one screen,  
show locations of each on sketch.