

Washington
K 1002
5-13-80

MISSISSIPPI
BOARD OF WATER COMMISSIONERS

416 North State Street
Jackson, Mississippi 39201 #1

WATER WELL DRILLERS LOG

Feb 26 1980 Larry's Well Pump Washington
date well completed firm name county well located

LANDOWNER: Buddy Cochran
Hollandale, MS
(mailing address)

description of formations encountered	from	to
clay	0'	20'
fine sand	20'	37'
fine to med sand	35'	55'
coarse sand	55'	90'
coarse sand & gravel	90'	115'

WELL LOCATION:

sec. 31 T. 16 (N) R. 8 (E)
S (W)
8 miles W of Hollandale
(distance) (direction) (nearest town)

WELL PURPOSE:
(home, irrigation, municipal, industrial)

WELL COMPLETION DATA:

- (1) diameter (inches) 16"
- (2) total depth (feet) 116'
- (3) static water level (feet) _____ below above top of ground.
- (4) casing steel, 76',
(material) (depth)

(size) If telescope see back.
- (5) screen 40', 76'
(length) (depth to top)
16", steel
(size) (material)
- (6) pump 60 3000
(HP) (yield gpm)

(type power)
- (7) electric log no
(yes or no)

(organization running log)

(8) how well bottom plugged
steel plate

DRILLERS REMARKS:


DEPT. OF NATURAL RESOURCES
BUREAU OF LAND & WATER RESOURCES

MAY 12 1980

RECEIVED

If well telescopes please sketch and show depths.

GROUND LEVEL

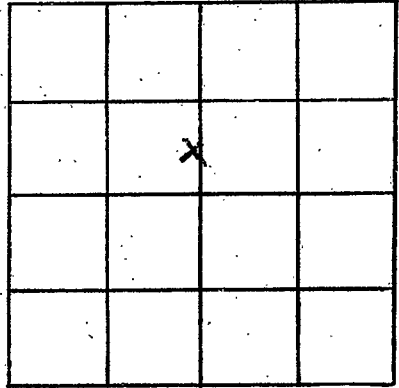

SECTION 31

Please indicate well location X.

ADDITIONAL INFORMATION

If more than one screen,
show locations of each on sketch.