

Washington
 K 2003
 8/10/76

MISSISSIPPI
 BOARD OF WATER COMMISSIONERS
 416 North State Street
 Jackson, Mississippi 39201

WATER WELL DRILLERS LOG
 Lambort Drilling Co.
 Joe Bordon

10 Aug 1976 date well completed
 firm name
 Wash county well located

LANDOWNER:	description of formations encountered	from	to
Joe Bordon			
Greenville Miss. (mailing address)	Mixed	0	30
WELL LOCATION: ? sec. 13 T 176 N R 8 E 8 S W	Sand	30	75
10 miles S of Greenville (distance) (direction) (nearest town)	Pea Gravel	75	115
WELL PURPOSE: none (home, irrigation, municipal, industrial)	Clay	115	180
WELL COMPLETION DATA:	Clay st sand	180	290
(1) diameter (inches) 4x2	Sand Fine	290	320
(2) total depth (feet) 440	Sand good	320	450
(3) static water level (feet) 42 below top of ground.			
(4) casing PVC 420 (material) (depth) 4x2 if telescope see back. (size)			
(5) screen 20' 446-420 (length) (depth to top) 2" PVC (size) (material)			
(6) pump 1 20 (HP) (yield gpm) elect (type power)			
(7) electric log (yes or no)			
(organization running log)			
(8) how well bottom plugged back wash			
DRILLERS REMARKS:			

RECEIVED
 SEP 27 1976

MISS. Bd. OF WATER COMMISSIONERS

If well telescopes please sketch and show depths.

GROUND LEVEL

140


4''

420

2''

440

2'' Steel

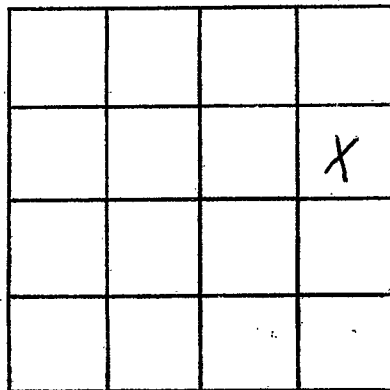

SECTION 13

Please indicate well location X.

ADDITIONAL INFORMATION

If more than one screen, show locations of each on sketch.