

Washington  
 K 2003  
 7/1/76

MISSISSIPPI  
 BOARD OF WATER COMMISSIONERS  
 416 North State Street  
 Jackson, Mississippi 39201

WATER WELL DRILLERS LOG

July 1 1976 date well completed  
 Schultz Drilling firm name  
 Washington county well located

LANDOWNER: Harvy Lynch

description of formations encountered

Greenwood Miss  
 (mailing address)

description of formations encountered	from	to
Clay	0	23
Sand	23	76

WELL LOCATION: ?  
 sec. 8 T. 126 N. R. 8 E.  
8 miles S of BVI  
 (distance) (direction) (nearest town)

Clay	76	230
Sand	230	280

WELL PURPOSE: Home  
 (home, irrigation, municipal, industrial)

sandy shell sand	280	410
------------------	-----	-----

WELL COMPLETION DATA:

sand	410	460
------	-----	-----

(1) diameter (inches) 2"

(2) total depth (feet) 450

(3) static water level (feet) 32 below top of ground.

(4) casing PVC (material) (depth) (size) If telescope see back.

(5) screen 10 (length) (depth to top) 3"

(6) pump 1 (HP) 10 (yield gpm) PVC (material)

(7) electric log NO (yes or no)

(organization running log)

(8) how well bottom plugged Spiral

DRILLERS REMARKS:


RECEIVED

AUG 24 1976

MISSISSIPPI BOARD OF WATER COMMISSIONERS

If well telescopes please sketch and show depths.

GROUND LEVEL

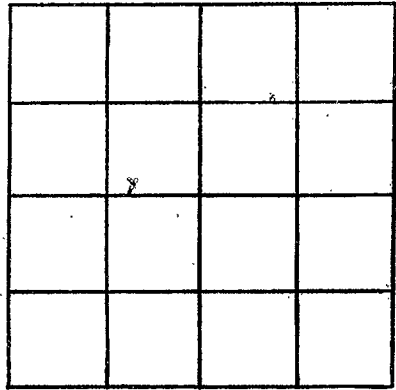

SECTION 8

Please indicate well location X.

ADDITIONAL INFORMATION

If more than one screen, show locations of each on sketch.