

WASHINGTON

K 2004

2-19-77

MISSISSIPPI BOARD OF WATER COMMISSIONERS

416 North State Street

151 Jackson, Mississippi 39201

WATER WELL DRILLERS LOG

2-19

date well completed

1977

firm name

Schultz Dilling

county well located

Washington

LANDOWNER:

Alexander Memorial Church

Hollandale Ms
(mailing address)

WELL LOCATION:

sec 26 T 16 N R 18 E
12 miles 5 of Owl
(distance) (direction) (nearest town)

WELL PURPOSE: Church
(home, irrigation, municipal, industrial)

WELL COMPLETION DATA:

- (1) diameter (inches) 4" x 2"
- (2) total depth (feet) 280
- (3) static water level (feet) 31 below top of ground
- (4) casing P.V.C.
(material) (depth)
(size) if telescope see back.
- (5) screen 20
(length) (depth to top)
2" P.V.C.
(size) (material)
- (6) pump 1
(HP) (yield gpm)
2 hp
(type power)
- (7) electric log (yes or no)
- (organization running log)
- (8) how well bottom plugged Church

description of formations encountered

from to

Clay	0	4
hard	4	83
Clay	83	140
shale + clay	140	160
sandy shale	160	240
sand	240	280


DRILLERS REMARKS:

RECEIVED JUN 7 1977

MISS. BU. OF WATER COMMISSIONERS

If well telescopes please sketch and show depths.

GROUND LEVEL

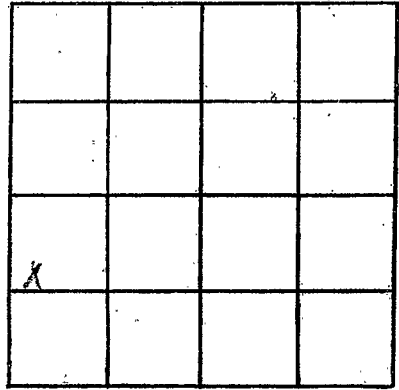

SECTION 26

Please indicate well location X.

ADDITIONAL INFORMATION

If more than one screen,
show locations of each on sketch.