

WASHINGTON

K 205

5-21-79

MISSISSIPPI
 BOARD OF WATER COMMISSIONERS
 416 North State Street
 Jackson, Mississippi 39201

WATER WELL DRILLERS LOG

5-21 1979 Schultz Drilling Co Washington
 date well completed firm name county well located

LANDOWNER: James Lee
 Wayside MS.

(mailing address)

description of formations encountered

from to

Clay	0	15
SAND	15	30
Sand gravel	30	60

WELL LOCATION:

sec. 10 T. 17¹⁶ S. R. 8 E. W. 1
 2 miles EAST of Wayside
 (distance) (direction) (nearest town)

WELL PURPOSE: Home
 (home, irrigation, municipal, industrial)

WELL COMPLETION DATA:

(1) diameter (inches) 2"
 (2) total depth (feet) 60'
 (3) static water level (feet) 16' below top of ground.

(4) casing PVC 55'
 (material) (depth)
 (size) if telescope see back.

(5) screen 5' 55'
 (length) (depth to top)
 2" PVC
 (size) (material)

(6) pump X X
 (HP) (yield gpm)
 (type power)

(7) electric log NO
 (yes or no)
 (organization running log)

(8) how well bottom plugged PVC cap

DRILLERS REMARKS:


Miss. Board of Water Comm.

MAY 21 1979

RECEIVED

If well telescopes please sketch and show depths.

GROUND LEVEL

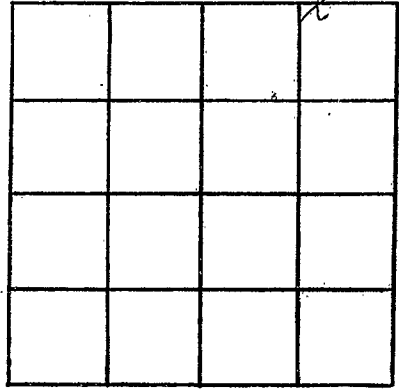

SECTION _____

Please indicate well location X.

ADDITIONAL INFORMATION

If more than one screen,
show locations of each on sketch.