

Washington
 K 2000
 9-26-80

MISSISSIPPI
 BOARD OF WATER COMMISSIONERS
 416 North State Street
 Jackson, Mississippi 39201

WATER WELL DRILLERS LOG

26 Sept 1980 Lambert Drilling Wash
 date well completed firm name county well located


LANDOWNER:	description of formations encountered	from	to
(mailing address)			
B. Johnson	Clay	0	68
Clon, m 1351	blue sand shale	68	72
WELL LOCATION: sec 22 T 16 N R 8 E 12 miles S of Greenville (distance) (direction) (nearest town)	Clay	72	330
WELL PURPOSE: none (home, irrigation, municipal, industrial)	Sand clayst	330	360
WELL COMPLETION DATA: (1) diameter (inches) 2" (2) total depth (feet) 415 (3) static water level (feet) 20 below top of ground. (4) casing PVC 405 (material) (depth) 2 (size) If telescope see back. (5) screen 10 415-405 (length) (depth to top) 2 PVC (size) (material) (6) pump 1 10 (HP) (yield gpm) elect (type power) (7) electric log (yes or no) (organization running log) (8) how well bottom plugged back press	Sand mod	360	390
DRILLERS REMARKS:	Sand good	390	415

DEPT. OF NATURAL RESOURCES
 BUREAU OF LAND & WATER RESOURCES

DEC 15 1980
 RECEIVED

If well telescopes please sketch and show depths.

GROUND LEVEL

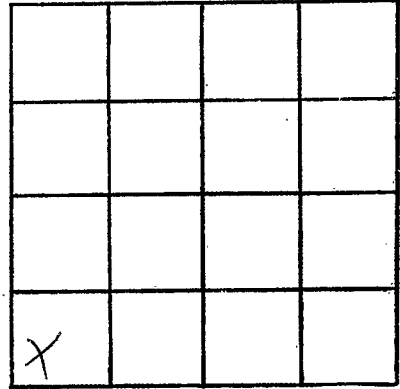

SECTION 22

Please indicate well location X.

ADDITIONAL INFORMATION

If more than one screen,
show locations of each on sketch.