

Washington
 R 2007
 4/8/80

MISSISSIPPI
 BOARD OF WATER COMMISSIONERS
 416 North State Street
 Jackson, Mississippi 39201

WATER WELL DRILLERS LOG

8 apr 1980 date well completed
 Lambert Drilling Co. firm name
 Wash county well located

LANDOWNER:	description of formations encountered	from	to
Joe Heranney			
Hollandale, miss. (mailing address)	Mixed	0	15
WELL LOCATION:	Sand	15	60
sec. 35 T. 16 N. R. 8 E 16 miles S of Greenville (distance) (direction) (nearest town)	Sand & gravel	60	84
WELL PURPOSE: none (home, irrigation, municipal, industrial)	Clay	84	240
WELL COMPLETION DATA:	Clay st Sand	240	300
(1) diameter (inches) 2	Sand (med)	300	320
(2) total depth (feet) 440	Sand, good	320	440
(3) static water level (feet) 28 below top of ground.			
(4) casing PVC, 430 (material) (depth)			
2 (size) if telescope see back.			
(5) screen 10, 440-430 (length) (depth to top)			
2, SS (size) (material)			
(6) pump 1 (HP) 9 (yield gpm)			
elect (type power)			
(7) electric log (yes or no)			
(organization running log)			
(8) how well bottom plugged back pres			
DRILLERS REMARKS:			


DEPT. OF NATURAL RESOURCES
 BUREAU OF LAND & WATER RESOURCES

MAY 29 1980

RECEIVED

If well telescopes please sketch and show depths.

GROUND LEVEL

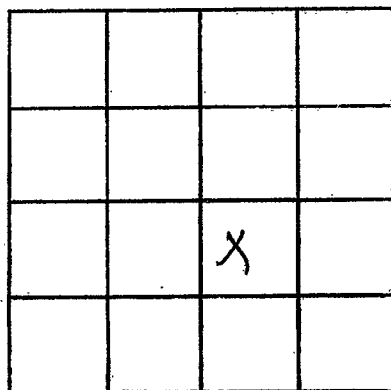

SECTION 35

Please indicate well location X.

ADDITIONAL INFORMATION

If more than one screen,
show locations of each on sketch.